
FORM 51 25M 3-49 PETROL KANSAS Graham

Section 7 Township 10 Range 21W

Well No. 1 McClellan

Company Rine Drlg et al 21

Wildcat

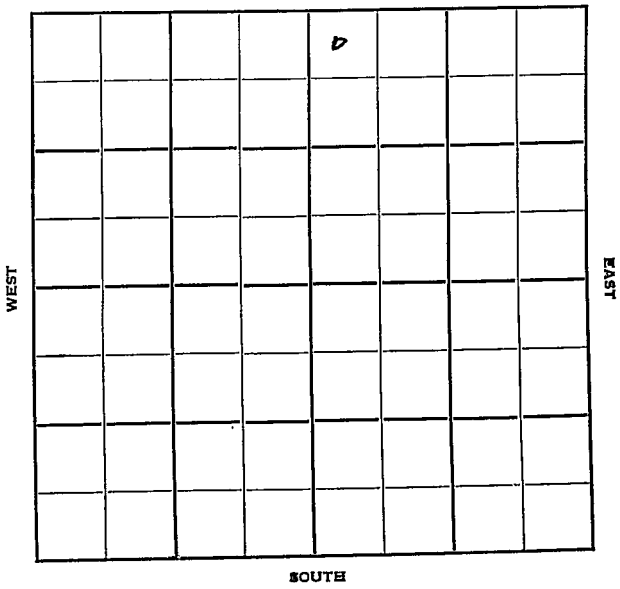

FORM 252-A
5M 10-48 PETROL

KANSAS Graham

Sec. 7 Twp. 10 R. 21W ✓

Well No. #1 McClellan Farm

Rine Drlg. et al Company

Wildcat


330' Ft. from N. Line

Ft. from S. Line

Ft. from E. Line

330' Ft. from W. Line

NW NE

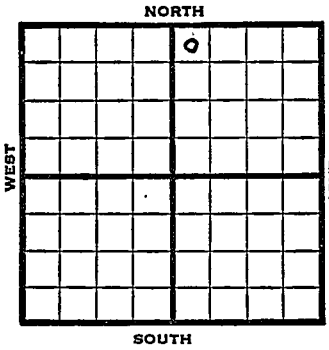

1949	Elev 2298' REPORT
4/13	Location
4/20	"
4/27	"
5/4	8"@ 173' Drlg 1225'
5/10	Lansing
5/18	TD 3950' Arb. 3912' Aband.

ABANDONED

Form 26 200 Bks. 9-48 Petrol

Kansas

Wildcat

Map No. _____ Sec. 7 Twp. 10 R. 21W

Well No. 1 McClellan

Rine Drlg. etal. Company

FIRST REPORT Contractor

NW NE

330 Ft. from N. Line


_____ Ft. from S. Line

_____ Ft. from E. Line

330 Ft. from W. Line

Graham County

SECTION PLAT

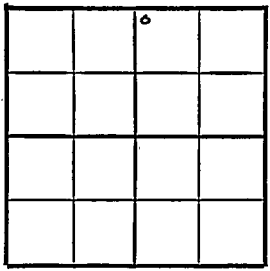

Location X

Rig up _____

Drilling and Remarks:

RECORD

Cased _____ in., _____ ft.

Sand _____

Gas _____

Oil _____

Total Depth _____

PRODUCTION

1st 24 hrs. Nat. _____

1st 24 hrs. after shot _____

Gas _____ Cu. Ft.

Dry Hole _____

Abandoned _____

Date

APR 13 1949 19

S. J. LEWIS Scout

Form 26 200 Bks. 9-48 Petrol

Kansas

Wildcat

Map No. K65 Sec. 7 Twp. 10 R. 21W

Well No. 1 McClellan


Rine Drlg. etal. Company

ABANDONED Contractor

NW NE

E/1,229 FT.

SECTION PLAT

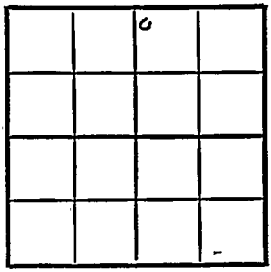

330 Ft. from N. Line

_____ Ft. from S. Line

_____ Ft. from E. Line

330 Ft. from W. Line

Graham County

Location

Rig up

Drilling and Remarks:

Cir & 3 9/12.

RECORD

Cased _____ in., _____ ft.

Sand

Gas

Oil

Total Depth 3750

PRODUCTION

1st 24 hrs. Nat.

1st 24 hrs. after shot

Gas Cu. Ft.

Dry Hole

Abandoned

Date

MAY 18 1949

19

S. J. LEWIS

Scout