

Section 7 Township 10 Range 21W

Well No. #1 McClellan

Company Barnett Drlg.

NORTH

0							

WEST

EAST

SOUTH

Sec. 7 Twp. 10 R. 21W ✓

Well No. #1 McClellan Farm

Barnett Drlg. Company

Barnett Drlg.-Contr. Contractor

Wildcat


330' Ft. from N. Line

\_\_\_\_\_ Ft. from S. Line

\_\_\_\_\_ Ft. from E. Line

330' Ft. from W. Line

NW NW NW

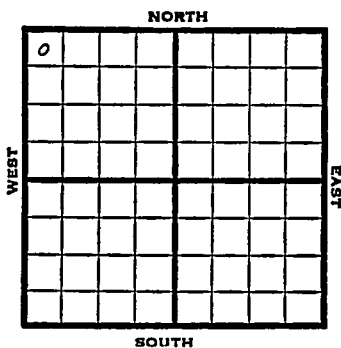

1950	Elev. 2320' REPORT
12/13	RUR
1951	
1/3	<p>Spud 12-11-50  D&amp;A TD 3957  8-5/8" @ 164'  Anhy 1805 Heeb. 3516  KC 3556'  DST 3586-3601 opn 1 hr  Rec. 5' ocm 180' socm  120' sw  DST 3686-98 opn 1 hr Rec. 70' mud  DST 3744-57 opn 35 min Rec. 63' socm  Arb. 3933 TD 3957 D&amp;A</p> <p style="text-align: center;"><b>ABANDONED</b></p>


County Graham State Kansas

Sec. 7 (Blk. 10) (Sur. 21W) (Twp.) (Rge.) Map No.

Operator Barnett Drlg.

Well No. 1 Farm McClellen

Elev. Location NW NW NW

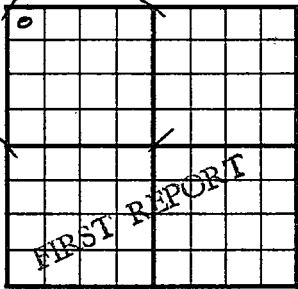

330 Ft. From N Line NW

330 Ft. From W Line Quarter

Ist. Report DEC 13 1950

Completion

Remarks

Barnett Drlg. - Contr.

Spudding Date

Drlg. Data Wildcat

RUR

J. E. TYRA

County Graham State Kansas

Sec. 7 (Blk. Twp.) 10 (Sur. Rge.) 21W Map No.

Operator Barnett Drlg.

Well No. 1 Farm McClellan

Elev. 2320 Location NW 1/4 NW

0					

ABANDONED

330 Ft. From N Line NW

330 Ft. From W Line Quarter

1st. Report

Completion JAN 3 1951

Remarks Wildcat

Barnett Drlg. - Contr.

Spudding Date 12-11-50

Drlg. Data D & A TD 3957

8 5/8" C 164 Anhv 1805 Heeb. 3516

KC 3556 DST 3586-3601 open 1 hr.

Rec. 5' ocm 180' socm 120' sw DST 3686-

98 open 1 hr. Rec. 70' mud DST 3744-57

open 35 min. Rec. 63' socm Arb. 3933

TD 3957 D & A