


Section 8 Township 10 Range 18W

Well No. 5 Wise

Company Mid-States

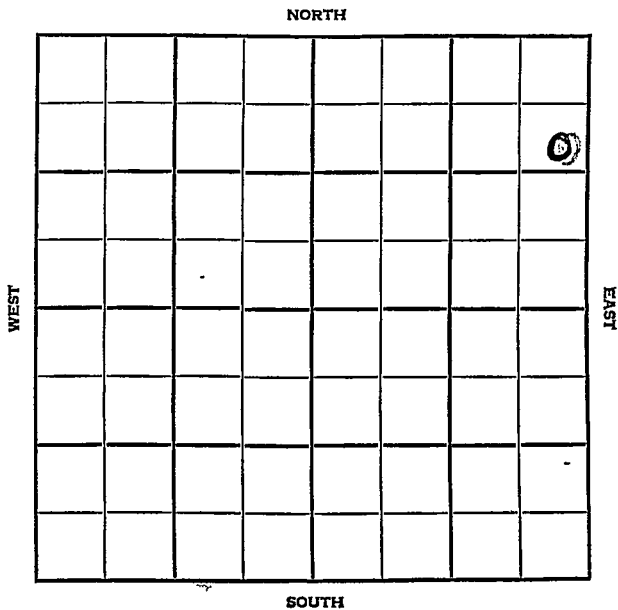

Rooks

KANSAS

| | | | | | |
|------|---|------|----|----|-----|
| SEC. | 8 | TWP. | 10 | R. | 18W |
|------|---|------|----|----|-----|

WELL NO.

5 Wise

FARM

COMPANY

Mid-States

CONTRACTOR

Barnett

Williams


_____ Ft. from N. Line

_____ Ft. from S. Line

_____ Ft. from E. Line

_____ Ft. from W. Line

SE NE NE

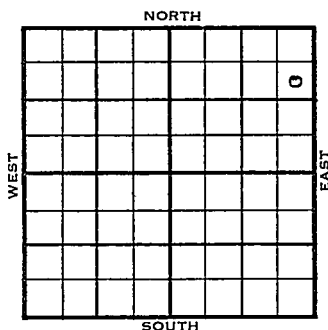

| 1955 | ELEVATION | REPORT |
|------|--|--------|
| | 2192' | |
| 6/29 | Location | |
| 9-21 | Comm. 7-5-55 | |
| | 10 3/4" @ 1593 w/900 | |
| | DST 3375-99 op 1 hr. rec 150' ocm, | |
| | BHP 930# 15"; | |
| | DST 3399-3420 op 1 hr. rec. 6' ocm, | |
| | 60' socm, BHP 380#; | |
| | DST 3457-78 op 1 hr. rec. 20' mud, | |
| | BHP 15#; | |
| | DST 3488-3500 op 1 hr. rec. 280' hocm, | |
| | ✓ wtr. plus 50' sw, BHP 480# 15"; | |
| | 5 1/2 " @ 3748; | |
| | CO 3750; CO 3750; 250 A; didn't take | |
| | Test 2 boph 2% sw; 1000 A; pmp 50 bo ✓ | |
| | 15% wtr. 24 hrs. | |
| | Phy. pmp 36 bopd ✓ 20% wtr. | |
| | Tops: TP 3153 | |
| | H. 3368- | |
| | Tr. 3386 | |
| | L. 3410 | |
| | C. 3646 | |
| | Sh 3733 | |
| | A 3747 | |
| | T.D. 3750' | |

COMPLETED

County Rooks Elev. _____
 Sec. 8 Twp. 10 Rge. 18W
 Company Mid-States
 Farm Name Wise No. 5

| TOPS | DEPTH | LOG | DATUM |
|--------|-------|-----|-------|
| Anh. | | | |
| Tp. | | | |
| H. | | | |
| Tr. | | | |
| Dg. | | | |
| Bl. | | | |
| L. | | | |
| K.C. | | | |
| B.K.C. | | | |
| Ce. | | | |
| C. | | | |
| M. | | | |
| M. | | | |
| K. | | | |
| Mz. | | | |
| Mo. | | | |
| V. | | | |
| S. | | | |
| S. | | | |
| A | | | |
| R. | | | |
| PE. | | | |
| G. | | | |
| TR. | | | |

Loc. in Sec. SE NE NE
 Geol. _____
 Contr. _____
Barnett
 Pool ~~Williams~~
 No. 6
FIRST REPORT
 JUN 29 '55

Date Comm. _____
 Location _____

Co.
 Lse.
 No.
 Sec.
 T.
 R.

County Rooks Elev. 2192
 Sec. 8 Twp. 10S Rgs. 18W
 Company Mid-States
 FarmName Wise No. 5

| TOPS | DEPTH | LOG | DATUM |
|--------|-------|-----|-------|
| Anh. | | | |
| Tp. | 3153 | | 961 |
| H. | 3368 | | 1176 |
| Tr. | 3386 | | 1194 |
| Dg. | | | |
| Bl. | | | |
| L. | 3410 | | 1218 |
| K.C. | | | |
| B.K.C. | | | |
| Ce. | | | |
| C. | 3646 | | 1454 |
| M. | | | |
| M. | | | |
| K. | | | |
| Mz. | | | |
| Me. | | | |
| V. Sh | 3733 | | 1541 |
| S. | | | |
| S. | 3747 | | 1555 |
| A. | | | |
| R. | | | |
| Pe. | | | |
| G. | | | |
| T.D. | 3750 | | |

Loc. in Sec. SE NE NE
 Geol. _____
 Contr _____
 Barnett
 Williams
 COMPLETE

Date Comm. 7-5-55 SEP 2 1 1955

10-3/4" 1593 w/900; DST 3375-99 op 1 hr.
 rec. 150' ocm, BHP 930# 15"; DST 3399-3420
 op 1 r., rec. 6' ocm, 60' socm, BHP 380#;
 DST 3457-78 op 1 hr. rec. 20' mud, BHP 15#;
 DST 3488-3500 op 1 hr. rec. 280' hocm / wtr.
 plus 50' sw, BHP-480# 15"; 5 1/2" 3748;
 CO 3750; CO 3750; 250 A; didnt take;
 test 2 boph 2% sw; 1000 A; pmp 50 bo plus
 15% wtr. 24 hrs.; Phy. Pmp 36 bopd / 20% wtr.

Co.
 Lse.
 No.
 Sec.
 T.
 R.