


Graham

KANSAS

SECTION 8 TOWNSHIP 10 RANGE 25W

WELL NO. #1 Rush

COMPANY Empire & Lebow

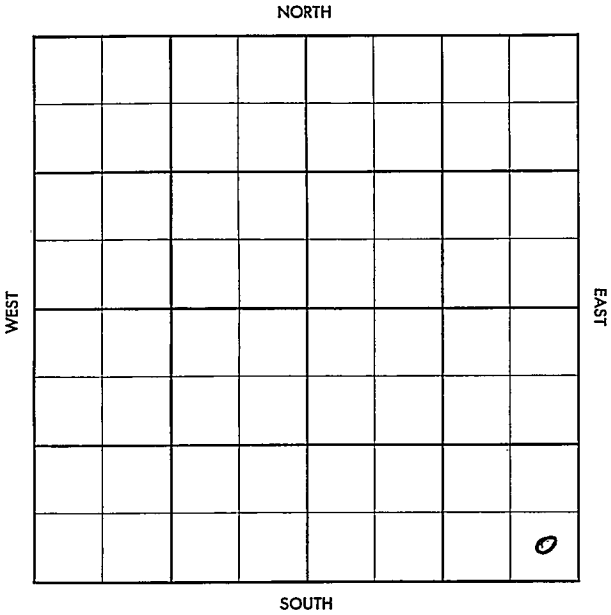

Graham

KANSAS

SEC. 8	TWP. 10	R. 25W
-----------	------------	-----------

WELL NO.

#1 Rush

FARM

COMPANY

Empire & Lebow

CONTRACTOR

Empire

~~###~~ WILDCAT


_____ Ft. from N. Line

_____ Ft. from S. Line

_____ Ft. from E. Line

_____ Ft. from W. Line

SE SE SE

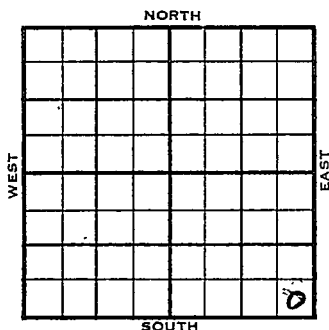~~###~~ - CRA - DHM

1956

ELEVATION

2547 KB, 2543 DF

REPORT

5-9

Location

5-23

Comm. 5-9-56

8 5/8" @ 174 w/115

DST 3845-70 op 45 min, rec. 16' WCM,
1300/30".

D&A

Anh. 2174', H. 3788', Tr. 3811',

L. 3831', BKC 4061',

TD 4090'

ABANDONED

County Graham Elev. _____
 Sec. 8 Twp. 10 Rgs. 25W
 Company Empire & Lebow
 FarmName Rush No. 1

TOPS	DEPTH	LOG	DATUM
Anh.			
Tp.			
H.			
Tr.			
Dg.			
Bl.			
L.			
K.C.			
B.K.C.			
Ce.			
C.			
M.			
M.			
K.			
Mz.			
Mo.			
V.			
S.			
S.			
A.			
R.			
Pe.			
G.			
T.D.			

Loc. in Sec. SE SE SE

Geol. _____

Contr. Empire

Pool _____

Wildcat

FIRST REPORT
 MAY 9 '56

Date Comm. GRA - DHM

Location _____

Co.
 Use.
 No.
 Sec.
 T.
 R.

3301 4 P YAM

1956

[Handwritten signature]

County Graham Elev. 2547 K13
 Sec. 8 Twp. 10 Rge. 25W 2543 D 7
 Company Empire & Lebow
 FarmName Rush No. 1

TOPS	DEPTH	LOG	DATUM	Loc. in Sec.
Anh.	2174			SE SE SE
Tr.				
H.	3788			
Tr.	3811			
Dg.				
Bl.				
L.	3831			
K.C.				Geol.
B.K.C.	4061			Contr.
Ce.				Empire
C.				
M.				Pool
M.				Wildcat
K.				
Mz.				
Me.				
V.				
S.				
S.				
A.				
R.				
PE.				
G.				
T.D.	4090			

ABANDONED
 MAY 23 1956

Date Comm. CRA - DHM
 Location MAY 16 '56 5-9-56 85/8
174/115 ~~10~~ 3585 MAY 23 '56
DST 3845-70 45" rec 16' WCM 1300/30"
DEA