


Section 8 Township 10 Range 17-~~W~~

Well No. #1 Federal Farm Mortgage

Company Harbor Drlg.

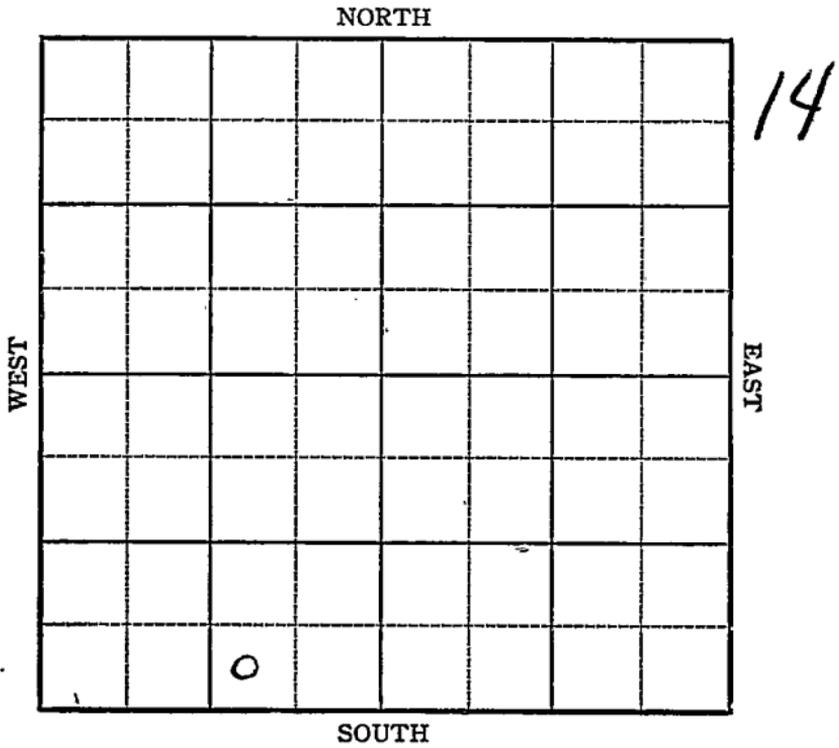

Sec. 8 Twp. 10 R. 17-W

Well No. #1 Federal Farm Mortgage Farm

Harber Drlg. Company


_____ Ft. from N. Line

330 Ft. from S. Line

990 Ft. from E. Line

_____ Ft. from W. Line

Elev. 2124

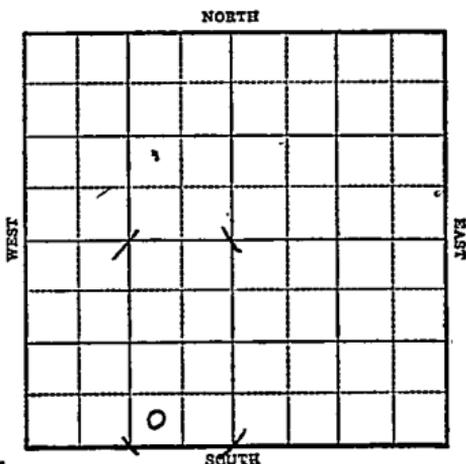

1943

R E P O R T

11/3 Derrick
11/10 10" @ 158
WOC
11/17 Anhy 2395
Drlg 2500'
12-1 Cong 3574
Simp 3649
Arb 3687
TD 3724

ABANDONED

KANSAS

Map No. 64 Sec. 8 Twp. 10 R. 17W

Well No. 1 Federal Farm Mortgage

Harbor Drlg. Company

FIRST REPORT

Contractor

SW SE SW


SECTION PLAT

_____ Ft. from N. Line

330 Ft. from S. Line

990 Ft. from E. Line

_____ Ft. from W. Line

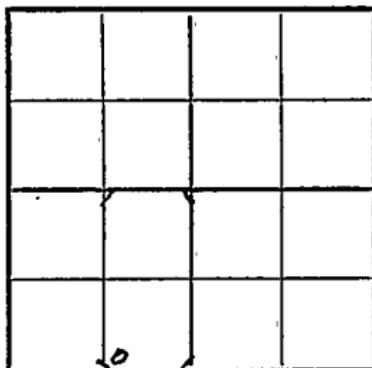

Wildcat

Location _____

Rig up _____

Drilling and Remarks:

Derrick

RECORD

Cased _____ in., _____ ft.

Sand _____

Gas _____

Oil _____

Total Depth _____

PRODUCTION

1st 24 hrs. Nat. _____

1st 24 hrs. after shot _____

Gas _____ Cu. Ft.

Dry Hole _____

Abandoned _____

Date

NOV 3 1943 19

S. J. LEWIS Scout

