


Section 8 Township 10 Range 18W

Well No. 2 Ordway

Company Atlantic Ref.

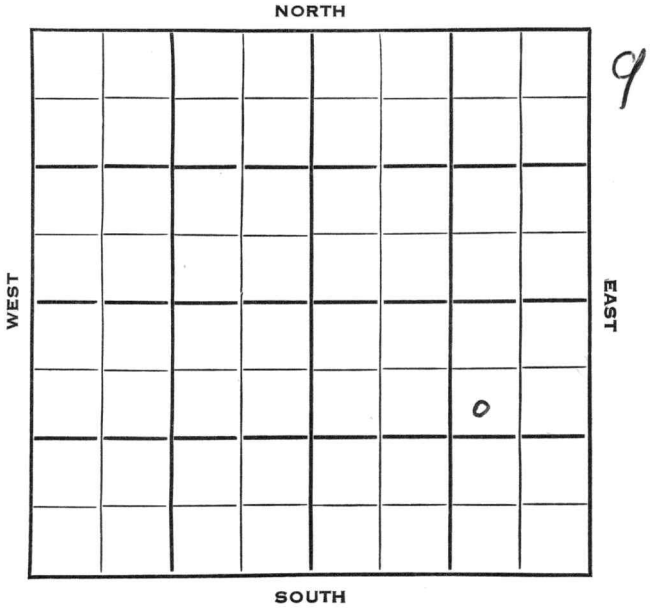

SEC.	8	TWP.	10	R.	18W	✓
------	---	------	----	----	-----	---

WELL NO.

#2 Ordway

FARM

COMPANY

Atlantic Ref.

CONTRACTOR

Nye

Williams

990


Ft. from N. Line

Ft. from S. Line

990

Ft. from E. Line

Ft. from W. Line

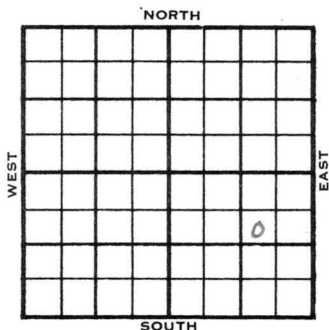

SW NE SE

1954	ELEVATION	2189'	REPORT
------	-----------	-------	--------

1/20

Location

1/27

10" @ 1266 WOC

2/3

Heeb 3383 Tor 3391 Lans 3424

DST 3462-79, 1½ hrs, 110' SW

1005#

DST 3474-94, 1 hr, 5' M O#

DST 3504-21

2/10

Spud 1-22-54 D & A TD 3810  
10" @ 1266 Heeb 3383 Tor 3391

Lans. 3424

DST 3462-79 open 1½ hr, rec 110' SW

~~1005#~~

DST 3474-94 open 1 hr rec 5' mud O#

DST 3504-21 open 1½ hr rec 105' SW

760# Cong. 3670 Simp. 3741

Arb. 3780' TD 3810' D &amp; A

**ABANDONED**

County Rooks State Kansas

Sec. 8 (Blk. 10 (Sur. 18W (Twp.) (Rge.) Map No.

Operator Atlantic Ref.

Well No. 2 Farm Ordway

Elev. Location SW NE SE

FIRST REPORT							
						0	

990 Ft. From N Line SE

990 Ft. From E Line Quarter

1st. Report JAN 20 1954

Completion

Remarks

Nye - Contr.

Spudding Date

Drlg. Data Williams

Location

