
FORM 51 Rooks

KANSAS

Section 8 Township 10 Range 18W

Well No. #1 Wise "A"

Company Mid-States

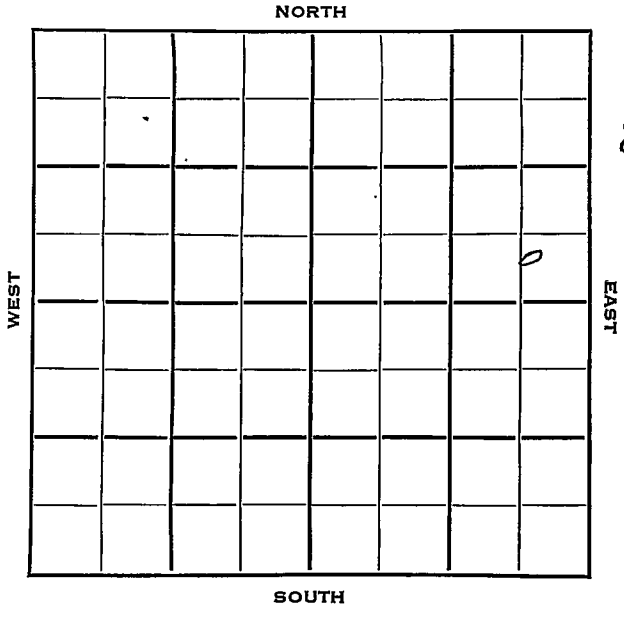

FORM 252-B

Rooks KANSAS

Sec. 8 Twp. 10 R. 18W

Well No. #1 Wise "A" Farm

Mid-States Company

Armer Contractor


____ Ft. from N. Line

330 Ft. from S. Line

330 Ft. from E. Line

____ Ft. from W. Line

SE SE NE

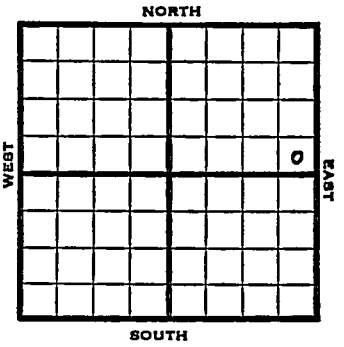

1953 Elev. 2192' REPORT

3/25 Spud 3-24-53

4/2 8" @ 1582 Anhy 1575
Drlg. 3085'

4/9 5" set.

4/16 "

4/23 NR

4/29 Spud 3-24-53
Oil Well
TD 3737
8" @ 1582
Anhy 1575, Top 3146, Heeb 3360
DST 3305-35, opn 1 hr., rec. 300' hocm, 50% oil, 1058#
DST 3366-95, opn 1 hr., rec. 180' hocm, 240' free oil, 1135#
Tor 3378, KC 3402,
DST 3402-13, opn 1 hr., rec. 428' oil, 1095#
DST 3438-45, opn 1 hr., rec. 45' ocm, 1135#
DST 3460-70, opn 1 hr., rec. 2600' free oil, 1200#
Cong 3638
DST 3639-56, opn 1 hr., rec, 8' mud, 700#
Simp 3711

OVER

#1 Wise "A"
(Information Brought Forward)

1953
4/29 DST 3712-20, opn 1 hr., rec. 5' oil,
20' ocm, 170#
Arb. 3734
TD 3736
5" @ 3734,
DD 3737, FU 200' oil, 4 boph, 250A
S/15 boph
Comp. 364 bopd

COMPLETED

FORM 275 FOR SALE BY KANSAS BLUE PRINT CO.


County Rooks State Kansas

Sec. 8 (Blk. Twp.) 10 (Sur. Rge.) 18W Map No.

Operator Mid-States

Well No. 1 Farm Wise "A"

Elev. Location SE SE NE

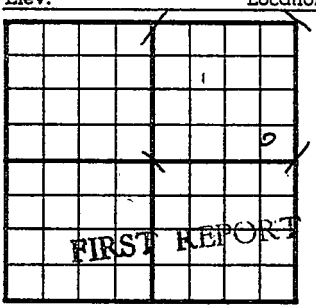

330 Ft. From S Line NE

330 Ft. From E Line Quarter

1st. Report MAR 25 1953

Completion

Remarks Armer - Contr.

Spudding Date 3-24-53

Drlg. Data

J. G. McGEHEE

FORM 275 FOR SALE BY KANSAS BLUE PRINT CO.


County Rooks State Kansas

Sec. 8 (Blk. Twp.) 10 (Sur. Rge.) 18W Map No.

Operator Mid-States

Well No. 1 Farm Wise "A"

Elev. 2192 Location SE SE NE

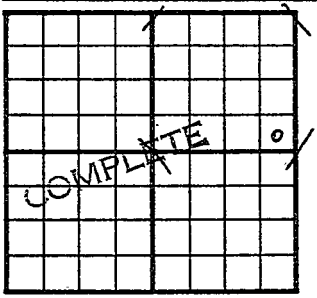

330 Ft. From S Line NE

330 Ft. From E Line Quarter

1st. Report

Completion APR 29 1953

Remarks

Armer - Contr.

Spudding Date 3-24-53

Drlg. Data Oil well TD 3737

8" @ 1582 Anhy 1575 Top. 3146

Heeb. 3360 DST 3305-35 open 1 hr.

Rec. 300' hocm 50% oil 1058#

DST 3366-95 open 1 hr. Rec. 180' hocm

240' free oil 1135# Tor. 3378 KC 3402

DST 3402-13 open 1 hr. Rec. 428' oil

1095# DST 3438-45 open 1 hr. Rec.

45' ocm 1135# DST 3460-70 open 1 hr.

Rec. 2600' free oil 1200# Conq. 3638

DST 3639-56 open 1 hr. Rec. 8' mud

700# Simp. 3711 DST 3712-20 open 1 hr.

Rec. 5' oil 20' ocm 170# Arb. 3734

TD 3736 5" @ 3734 DD 3737 FU 200' oil

4 boph 250 A S/ 15 boph

Comp. 364 bopd

J. G. McGEHEE