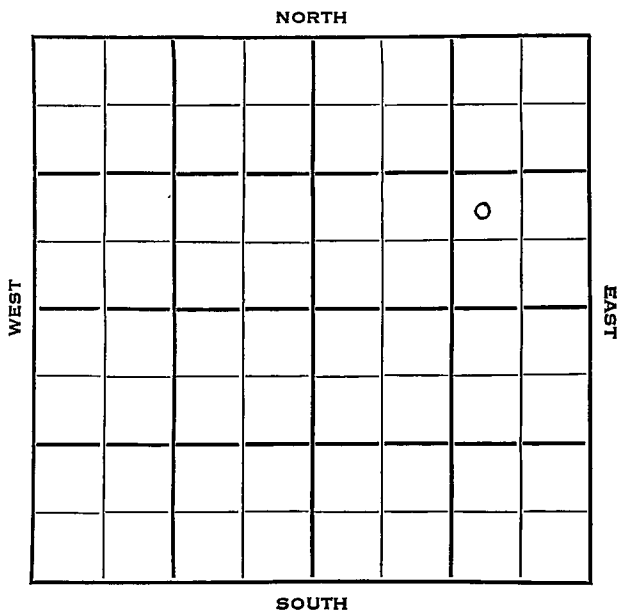


Section 8 Township 10 Range 18WWell No. 2 - Wise "A"Company Mid-States

Rooks KANSAS

Sec. 8 Twp. 10 R. 18 W

Well No. # 2 Wise "A" Farm

Mid-States Company

Armer Contractor

Williams Pool


Ft. from N. Line

990 Ft. from S. Line

990 Ft. from E. Line

Ft. from W. Line

NW SE NE

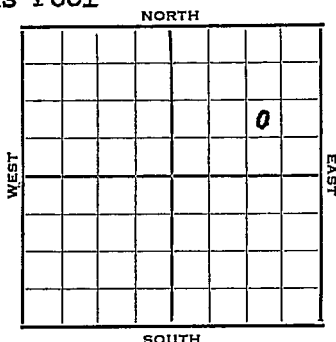

1953

Elev. 2193' REPORT

- 4/8 Spud 4-8-53
4/16 8" @ 1587'
4/23 Anhy 1577, Top 3149, Heeb 3364, Tor 3381
DST 3370-95, 1 hr., 210' HO&GCM, 1065#
Lans 3406
DST 3418-30, 1 hr., 5' M
DST 3463-74, 1 hr., gas in ___?
3000' O&G 270#
Drlg. 3620'
4/30 Cong 3639
DST 3718-26, failed
DST 3720-26, 1 hr., 900' oil, 1120#
Simp 3700, Arb. 3740,
TD 3742
5" @ 3740½
5/6 CO 3742' 50 A S/18 BOPH 11 hrs.
S/13½ BO 3rd hr.
5/13 Spud 4-8-53
Oil Well
TD 3742'
8" @ 1587'
Anhy 1577, Top. 3149, Heeb 3364, Tor 3381
DST 3370-95 opn 1 hr, rec 210' ho & gcm
1065# Lans 3406

OVER

1953

Information brought forward.--

5/13

DST 3418-30 opn 1 hr, rec 5' mud,
DST 3463-74 opn 1 hr, gas in 50 min,
rec 3000' o & gas FU 270# Cong 3639,
DST 3718-26 failed
DST 3720-26 opn 1 hr, rec 900' oil,
1120# Simp 3700, Arb 3740
TD 3742
5" @ 3740'
CO to 3742
50 A
S/ 18 boph S/ $13\frac{1}{2}$ bo
Comp. 397 bopd.

COMPLETED

County Rooks State Kansas

Sec. 8 (Blk. Twp.) 10 (Sur. Rge.) 18W Map No.

Operator **Mid-States**

Well No. **2** Farm **Wise "A"**

Elev.	Location	NW	SE	NE
-------	----------	----	----	----

0

FIRST REPORT

990 Ft. From S Line NE

990	Ft. From	E	Line	Quarter
-----	----------	---	------	---------

1st. Report APR 8 1953

Completion

Remarks


Armer - Contr.

Spudding Date 4-8-53

Drig. Data Williams Pool

J. G. McGEHEE

County _____ Rooks _____ State Kansas
 Sec. 8 (Blk. Twp.) 10 (Sur. Rge.) 18W Map No. _____
 Operator Mid-States
 Well No. 2 Farm Wise "A"
 Elev. 2193 Location NW SE NE

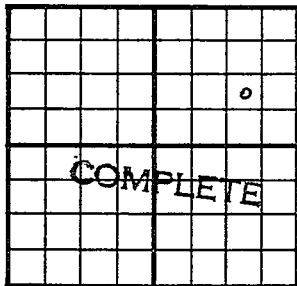

990 Ft. From S Line NE
 990 Ft. From E Line Quarter
 1st. Report _____
 Completion MAY 13 1953
 Remarks Williams Pool
Armer - Contr.
 Spudding Date 4-8-53

Drlg. Data Oil well TD 3742
8" @ 1587 Anhy 1577 Top. 3149
Heeb. 3364 Tor. 3381 DST 3370-95
open 1 hr. Rec. 210' ho & gcm 1065#
Lans. 3406 DST 3418-30 open 1 hr.
Rec. 5' mud DST 3463-74 open 1 hr.
gas in 50 min. Rec. 3000' o & gas FU
270# Cong. 3639 DST 3718-26 failed
DST 3720-26 open 1 hr. Rec. 900' oil
1120# Simp. 3700 Arb. 3740 TD 3742
5" @ 3740 CO to 3742 50 A
S/ 18 boph S/ 13½ bo
Comp. 397 bopd

J. G. McGEHEE