


Section 8 Township 10 Range 19W

Well No. #2 Dick

Company Magnolia

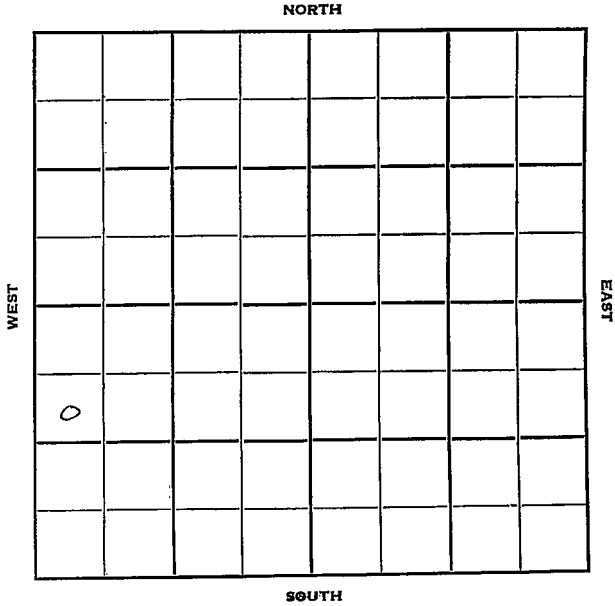

Sec. 8 Twp. 10 R. 19 W ✓

Well No. # 2 Dick Farm

Magnolia Company

Barnett Drlg. Contractor

Berland Pool


990 Ft. from N. Line

_____ Ft. from S. Line

_____ Ft. from E. Line

330 Ft. from W. Line

SW NW SW

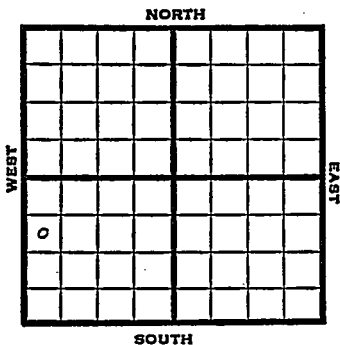

1951 Elev. 2209' REPORT

8/29 R U R

9/12 Spud 8-29-51 D & A
TD 3872' 8" @ 190

Lans. 3461'

DST 3647-63 open 1 hr. rec 10' mud

Arb. 3822'

TD 3872' D & A

ABANDONED

County Rooks State Kansas

Sec. 8 (Blk. 10 (Sur. Rge.) 19W Map No.

Operator Magnolia

Well No. 2 Farm Dick

Elev. _____ Location SW NW SW

990 Ft. From N Line SW

330 Ft. From W Line Quarter

Ist. Report AUG 29 1951

Completion _____

Remarks _____

Barnett Drlg. - Contr.

Spudding Date _____

Drlg. Data Berland Pool

RUR

County _____ Rooks _____ State Kansas

Sec. 8 (Blk. Twp.) 10 (Sur. Rge.) 19W Map No. _____

Operator Magnolia

Well No. 2 Farm Dick

Elev. 2209 Location SW NW SW

ABANDONED

990 Ft. From N Line SW

330 Ft. From W Line Quarter

1st. Report

Completion SEP 12 1951

Remarks Berland Pool

Barnett Drlg. - Contr.

Spudding Date 8-29-51

Drlg. Data D & A TD 3872

8" @ 190 Lans. 3461 DST 3647-63

open 1 hr. Rec. 10' mud Arb. 3822

TD 3872 D & A

J. E. TYRA