


Section 8 Township 10 Range 19 W

Well No. # 1 Bartos

Company Bartlett

NORTH

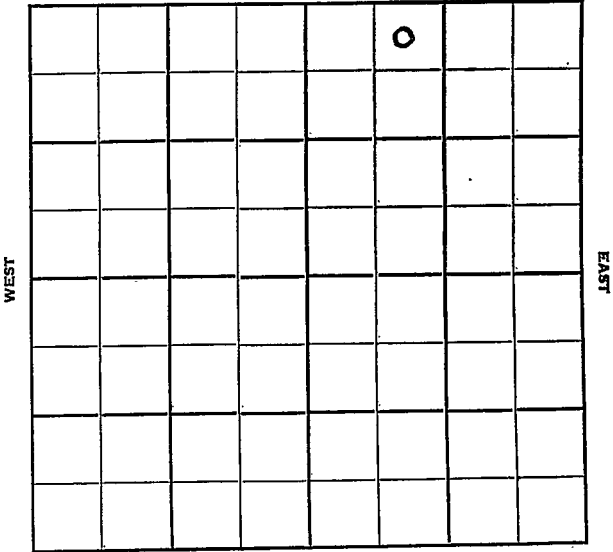

SOUTH



Rooks

Sec. 8 Twp. 10 R. 19W

Well No. #1 Bartos Farm

Bartlett Company

B & B Drlg. - Contr. Contractor


330' Ft. from N. Line

_____ Ft. from S. Line

_____ Ft. from E. Line

990' Ft. from W. Line

NE NW NE

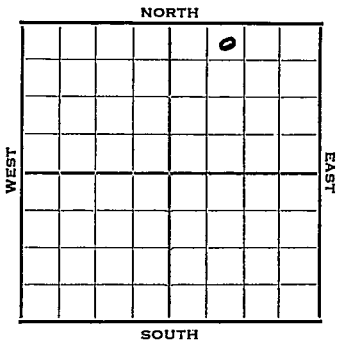

1952

Elev. 2221' REPORT

6/4

Spud 5-29-52
8" @ 184
Anhy 1615
Drlg. 2865'

6/11

Spud 5-29-52
D & A TD 3777' 8" @ 184
Anhy 1615' Heeb 3424' Lans. 3461'
DST 3605-35 open 1 hr. rec 10' mud
Cong. 3696' Simp. 3738' Arb. 3769'
DST 3770-77 open 1 1/2 hr. rec 255' SW
TD 3777'
D & A

ABANDONED

County Rooks State Kansas

Sec. 8 (Blk. Twp.) 10 (Sur. Rge.) 19W Map No.

Operator Bartlett

Well No. 1 Farm Bartos

Elev. 2221 Location NE NW NE

ABANDONED

330 Ft. From N Line NE
990 Ft. From W Line Quarter

Ist. Report

Completion JUN 11 1952

Remarks

B & B Drlg. - Contr.

Spudding Date 5-29-52

Drlg. Data D & A TD 3777

8" @ 184 Anhy 1615 Heeb. 3424

Lans. 3461 DST 3605-35 open 1 hr.

Rec. 10' mud Cong. 3696 Simp. 3738

Arb. 3769 DST 3770-77 open $\frac{1}{2}$ hr.

Rec. 255' sw TD 3777

D & A