


Section 8 Township 10 Range 19 W

Well No. #1 Bartos

Company Davis Bros. (Tulsa)

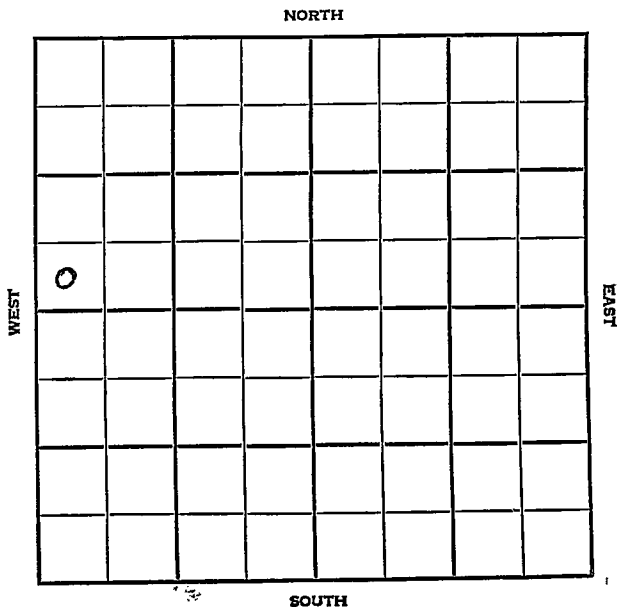

County Roofs Elev. _____
 Sec. 8 Twp. 101 Rge. 19W
 Company Davis Bros. (tulsa)
 FarmName Bartos No. 1

| TOPS | DEPTH | LOG | DATUM | Loc. in Sec. |
|--------|-------|-----|-------|------------------|
| Anh. | | | | SW SW NW |
| Tp. | | | | |
| H. | | | | |
| Tr. | | | | |
| Dg. | | | | |
| Bl. | | | | |
| L. | | | | |
| K.C. | | | | Geol. _____ |
| B.K.C. | | | | Contr. _____ |
| Ce. | | | | <u>Transit</u> |
| C. | | | | |
| M. | | | | Pool _____ |
| M. | | | | <u>Marquette</u> |
| K. | | | | |
| Mz. | | | | |
| Mo. | | | | |
| V. | | | | |
| S. | | | | |
| S. | | | | |
| A. | | | | |
| R. | | | | |
| PE. | | | | |
| G. | | | | |
| T.D. | | | | |

FIRST REPORT
 MAR 22 1956

Date Comm. 3-9-56 MAR 14 1956

8" @ 162/125 drlg. 2300

Co.
 Lse.
 No.
 Sec.
 T.
 R.

County Rocks Elev. 2217
 Sec. 8 Twp. 10 Rge. 19W
 Company Davis Bros.
 Farm Name Bartos No. 1

| TOPS | DEPTH | LOG | DATUM |
|--------|-------|-----|-------|
| Anh. | 1638 | | |
| Tp. | | | |
| H. | 3449 | | |
| Tr. | 3470 | | |
| Dg. | | | |
| Bl. | | | |
| L. | 3487 | | 127.0 |
| K.C. | | | |
| B.K.C. | | | |
| Ce. | | | |
| C. | 3743 | | 1526 |
| M. | | | |
| M. | | | |
| K. | | | |
| Mz. | | | |
| Ma. | | | |
| V. | | | |
| S. | | | |
| S. | | | |
| A. | 3804 | | 1587 |
| R. | | | |
| PE. | | | |
| G. | | | |
| T.D. | 3812 | | |

Loc. in Sec. SW SW NW
 Geol. _____
 Contr. Transit
 Pool Gick
Mazette
ABANDONED
 MAR 28 '58

Date Comm. 3-9-56
8" @ 162/125 DST 3804-12 open 1 hr.
rec. 1700' sw 860#

D & A

Co.
 No.
 Sec.
 T.
 R.