

Rooks

KANSAS

8

10

19W

SECTION _____ TOWNSHIP _____ RANGE _____


WELL NO. #1 BartosCOMPANY Murfin Drlg.

NORTH

SE SE NE

WEST

EAST

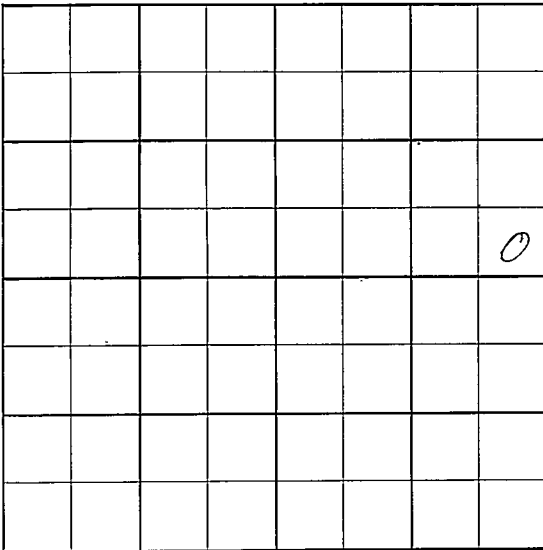

SOUTH

FORM 513 SUNRAY

TOPS	DEPTH	LOG	DATUM
Anb.			
TP.			
H.			
Tr.			
Dg.			
BL.			
L.			
K.C.			
B.K.C.			
Ce.			
C.			
M.			
M.			
K.			
Mz.			
Me.			
V.			
S.			
S.			
A.			
R.			
Pf.			
G.			
F.D.			

Lot. n Sec.
SE SE NE

Geol.

Contr.

Co. Tools

Pool. SICK

Wildcat

APR 10 '57

FIRST REPORT

Date Comm.

MIRT

County Rocks Elev. 2205
 Sec. 8 Twp. 10 Rge. 19W
 Company Murfin Drilling
 Farm Name Bartos No. 1

TOPS	DEPTH	LOG	DATUM	Loc. in Sec.
Anh.	1595			SE SE NE
Top.	3198			
H.	3410			
Tr.	3428			
Dg.				
Bl.				
L.	3448			
K.C.				Geol.
B.K.C.	3665			Contr.
Ce.				
C. <u>clerty</u>	3714			Co. Tools
M.				Glick
M.				Wildcat
K.				
Mz.				
Ma.				
V.				
S.	3768			
S.				
A.	3791			
R.				
Pe.				
G.				
T.D.	3801			

ABANDONED

APR 24 '57

Date Comm.

MIRT APR 17 '57 4-12-57 85/8170

1135 3010 APR 24 '57

D&W