

Company Heathman Drlg

WEST

EAST

①

SOUTH

Rooks

KANSAS

Sec. 8 Twp. 10 R. 19W

Well No. #1 Henderson Farm

Heathman Drlg.

Company

Contractor

Ft. from N. Line

330'


Ft. from S. Line

Ft. from E. Line

330'

Ft. from W. Line

SW SW SE

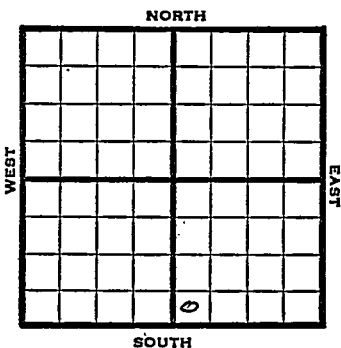

1950

Elev. 2208' REPORT

3/8

Spud 3-2-50

8" @ 128'

Anhy 1620'

Drlg. 2560'

3/15

TD 3848'

8"@ 128'

Topeka 3215'

Heeb 3428'

KC 3468'

BKC 3678'

Cong 3747'

Simp 3769'

Arb. 3832

No shows

D&A

Aband.

ABANDONED

Kansas

Map No. _____ Sec. 8 Twp. 10 R. 19WWell No. 1 Henderson

_____ Heathman Drlg. _____ Company

_____ Contractor


SW SW SE

E1. 2208
SECTION PLAT

_____ Ft. from N. Line

330 Ft. from S. Line

_____ Ft. from E. Line

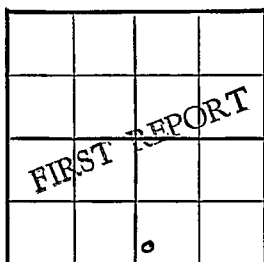330 Ft. from W. Line

Rooks County

Sunray DHM

Location _____

Rig up _____

Drilling and Remarks: _____

Spud 3-2-50

8" @ 128

Anhy 1620

drlg. 2560

RECORD

Cased _____ in., _____ ft.

Sand _____

Gas _____

Oil _____

Total Depth _____

PRODUCTION

1st 24 hrs. Nat. _____

1st 24 hrs. after shot _____

Gas _____ Cu. Ft.

Dry Hole _____

Abandoned _____

Date

MAR 8 1950 19J. E. TYRA

Scout

Kansas

Map No. _____ Sec. 8 Twp. 10 R. 19WWell No. 1 Henderson

Heathman Drlg.

Company _____

Contractor _____

SW SW SE

E. 2208
SECTION PLAT

ABANDONED			

_____ Ft. from N. Line

330 Ft. from S. Line

_____ Ft. from E. Line

330 Ft. from W. Line

Rooks County

Location _____

Rig up _____

Drilling and Remarks:

8" @ 128
 Type 3215
 Rev 3428
 KC 3468
 BKC 3678
 Cong 3747
 Sinter 3769

Rev 3832 no shows
 Date DYA

RECORD

Cased _____ in., _____ ft.

Sand _____

Gas _____

Oil 3848

Total Depth _____

PRODUCTION

1st 24 hrs. Nat. _____

1st 24 hrs. after shot _____

Gas _____ Cu. Ft.

Dry Hole _____

Abandoned _____

MAR 15 1950

19

J. E. TYRA

Scout