

Graham


KANSAS

SECTION 8 TOWNSHIP 10 RANGE 23W

WELL NO. #1 Dietz

COMPANY Prime Drlg.

NORTH C N/2 NW SW

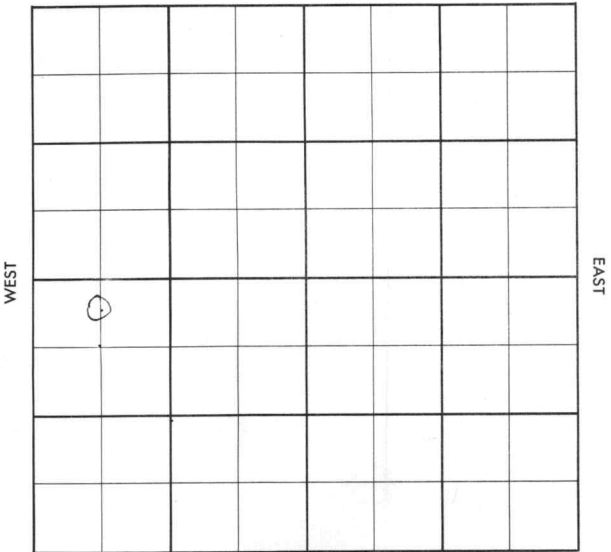

County Graham Elev. \_\_\_\_\_  
 Sec. 8 Twp. 10 Rge. 23W  
 Company Prime Drlg.  
 Farm Name Dietz No. 1

TOPS	DEPTH	LOG	DATUM	Loc. in Sec.
Anh.				C N/2 NW SW
Tr.				
H.				
Tr.				
Dg.				
Bl.				
L.				Geol. _____
K.C.				Contr. _____
B.K.C.				Co. Tools
Ce.				Pool <u>HAPPY</u>
C.				Hoof West
M.				
M.				
K.				
Mz.				
Me.				
V.				
S.				
S.				
A.				
R.				
PE.				
G.				
T.D.				

MAR 6 57  
 FIRST REPORT

Date Comm. 3-1-57  
8" @ 242/175, Drlg. 2675

*(Handwritten scribble)*

Co.

Use

No.

Sec.

T.

R.

Happy

FORM 513 SUNRAY

County Graham Elev. 2385 Co. \_\_\_\_\_  
 Sec. 8 Twp. 10 Rge. 23W  
 Company Prime Drlg.  
 Farm Name Dietz No. 1

TOPS	DEPTH	LOG	DATUM	Loc. in Sec.
Anh.	1990			C N/2 NW SW
TP.				
H.	3692			
Tr.	3711			
Dg.				
Bl.				
L.	3726			Geol. _____
M.C.				Cantr. _____
B.K.C.				Co. Tools _____
Ce.				Pool _____
C.				Hoof West _____
M.				
M.				
K.				
Mz.				
Mq.				
V.				
S.				
S.				
A.				
R.				
PE.				
G.				
T.D.	3955			

COMPLETE  
 MAY 29 '57

Date Comm. 3-1-57  
 8" @ 242/175, Drlg. 2675 MAR 13 '57  
 DST 3872-92 (90) 275' 61P 40'  
 HOCM 50' 50CM BHP 290(20)  
 DST 3909-3932(60) 90' OCM, 180'  
 MCO, 180' O.I. BHP 1300(25)  
 \$ 3932 MAR 20 '57 5 1/2 3931/125  
 CO MAR 27 '57 CO 28/3882-90 S.O.  
 1/2 \$ 5 BupL 3 hrs row  
 S.O. 12 hrs FU 600' oil row P&P  
 APR 3 '57 APR 10 '57 APR 17 '57 APR 24 '57

P. 20 Bopd 190 W5 MAY 1 '57  
MAY 8 '57 MAY 15 '57 MAY 22 '57 MAY 29 '57

Ph P. 80 Bopd nslw  
grau 32°