

Graham


KANSAS

SECTION 8 TOWNSHIP 10S RANGE 23W

WELL NO. #2 Dietz

COMPANY Prime Drlg., etal

NORTH N/2 N/2 SW

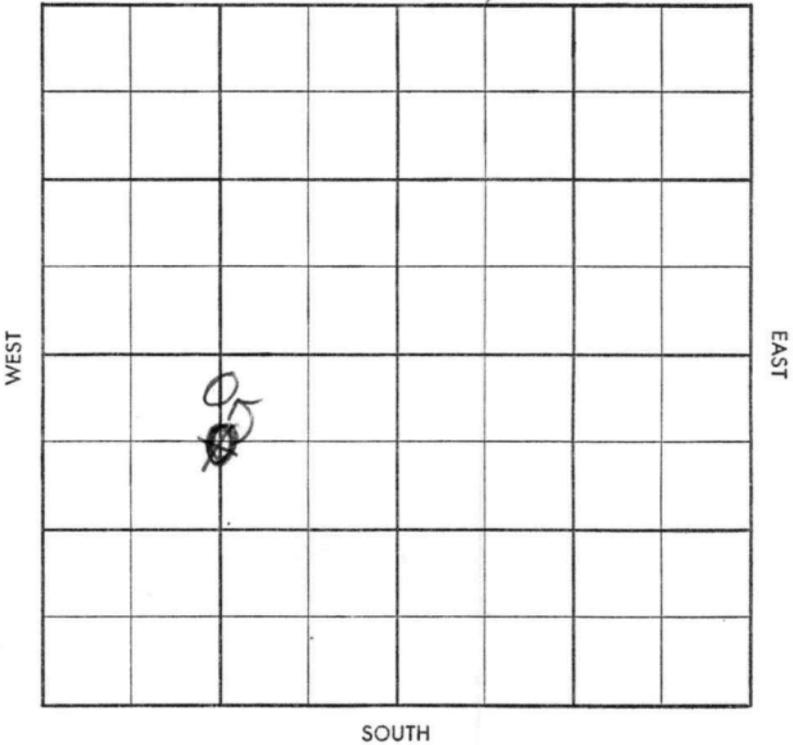



CORRECTION

Happy

CO. Graham

ELEV. 240

COMPLETE

SEC. 8 TWP. 10 RGE. 23W

COMPANY Prime "rlg. ettl" NO. 2

FEB 5 '58

Pet Management + operating

FARM Dietz

LOC. ~~G N/2 SW~~ N/2 N/2 SW

H 3713
TR 3741
L 3751
TP 3995

GEOL. \_\_\_\_\_  
CONTR. Co. Tools #3 rig

POOL \_\_\_\_\_  
SPUD 12/6/57

8" @ 258 w/175, Dr. g.  
2570. DEC 18 '57 Ø 3410  
DEC 26 '57 pipe set  
3 DST 3544-56  
90" 190' SW

BHP 1036 DST

3898 - 3918 60" 55' OCM

BHP 141 DST 3934-60

90" 65' OCM BHP 105

5 1/2 3994 1/2 JAN 2 '58 JAN 8 '58

24/3941-47 750A \$ 6 1/2 BOPH

NW gr 33.1° PB 3930

20/3907-12 \$ 1090 1/2 \$ 2 1/2

BOPH 3 hrs NW 2500A

JAN 15 '58 JAN 22 '58 \$ aver 6.38 B0

PH NW POP JAN 29 '58 FEB 5 '58

Phy P 85 BOPH NW  
gr 33°