


Section 8 Township 10 Range 18W

Well No. #3 Wise "A"

Company Mid-States Oil

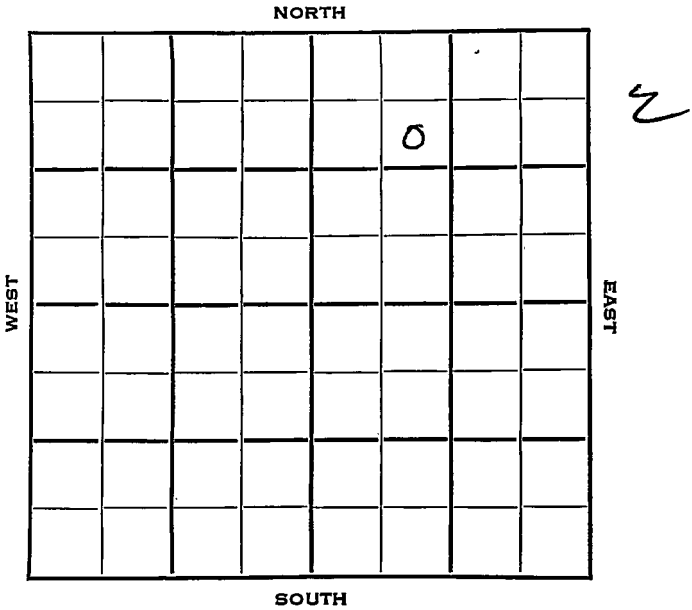

Rooks

KANSAS/

Sec. 8 Twp. 10 R. 18W

Well No. #3 Wise "A" Farm

Mid-States Oil Company

Armer Contractor

Williams Pool


990 Ft. from N. Line

 Ft. from S. Line

 Ft. from E. Line

990 Ft. from W. Line

SE NW NE

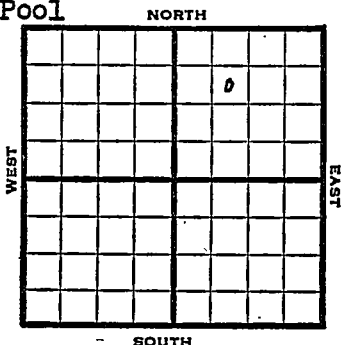

1953 Elev. 2191' REPORT

4/29 Spud 4-24-53
8" @ 1857'
Anhy 1577'
WOC

5/6 Top 3158' Heeb 3376 Tor 3394
DST 3382-3410, 1 hr, 100' SW 1140#
Lans 3418'
DST 3419-29, 1 hr, 9' M 510#
DST 3444-60, 1 hr, 30' SW 1085#
DST 3474-88 1 hr, 2' M 0#

5/21 Cong 3652' Arb. 3887'
DST 3556-82, 1½ hrs, 420' SW 1135#
DST 3586-3620, 1½ hrs, 10' oil, 55'
O & GCM, 1010# RTD 4109
5" @ 3937 CO

5/28 Testing

6/3 "

6/10 Spud 4-24-53
SWD Well
TD 4113'
8" @ 1857'
Anhy 1577, Top 3158, Heeb 3376, Tor 3394,
DST 3382-3410 opn 1 hr, rec 100' sw 1140# Lans 3418'
DST 3419-29 opn 1 hr, rec 7' mud 510#

OVER

1953

Information brought forward.

6/10 DST 3444-60 opn 1 hr, rec 30' sw
1085#
DST 3474-88 opn 1 hr, rec 2' mud
O# Cong3652, Arb 3887
DST 3556-82 opn $1\frac{1}{2}$ hr, rec 420' sw
1135#
DST 3586-3620 opn $1\frac{1}{2}$ hr, rec 10' oil
55' o & gcm 1010#
TD 4109'
5" @ 3937'
GO to 4109' SP 3750 24/ 3738-44
500 A S/ 8 bfpd 25% hvy oil SP
3700 84/ 3586-3600 500 A S/
3 bwph & SSO S/ 4 bfph
16/ 3614-18 S/ 5 bfph 20% oil
500 A S/ $7\frac{1}{2}$ bw $\frac{1}{2}$ bo 3 hr.
SP 3650 40/ 3476-86 40/3453-63
500 A S/ sw 16/ 3502-06 $1\frac{1}{2}$ bswph
500 A 22 bswph DD 4113 3000 A
Comp. for SWD Well.

ABANDONED

County Rooks State Kansas
 Sec. 8 (Blk. 10 (Sur. 18W Map No.
 (Twp.) (Rge.)
 Operator Mid-States Oil
 Well No. 3 Farm Wise "A"
 Elev. Location SE NW NE

990 Ft. From N Line NE
990 Ft. From W Line Quarter
 1st. Report APR 29 1953
 Completion
 Remarks
Armer - Contr.
 Spudding Date 4-24-53

Drilg. Data Williams Pool
8" @ 1857 Anhy 1577 WOC

J. G. McGEHEE

County _____ Rocks _____ State Kansas
 Sec. 8 (Blk. 10 (Sur. 18W Map No. _____
 (Twp.) (Rge.)
 Operator Mid-States Oil
 Well No. 3 Farm Wise "A"
 Elev. 2191 Location SE NW NE



990 Ft. From N Line NE

990 Ft. From W Line Quarter

1st. Report _____

Completion JUN 10 1953Remarks Williams PoolArmer - Contr.Spudding Date 4-24-53Drig. Data SWD well TD 41138" @ 1857 Anhy 1577 Top. 3158Heeb. 3376 Tor. 3394 DST 3382-3410open 1 hr. Rec. 100' sw 1140#Lans. 3418 DST 3419-29 open 1 hr.Rec. 7' mud 510# DST 3444-60open 1 hr. Rec. 30' sw 1085#DST 3474-88 open 1 hr. Rec. 2' mud0# Cong. 3652 Arb. 3887 DST 3556-82open 1½ hr. Rec. 420' sw 1135#DST 3586-3620 open 1½ hr. Rec. 10' oil55' o & gcm 1010# TD 4109. 5" @ 3937CO to 4109 SP 3750 24/ 3738-44 500 AS/ 8 bfpd 25% hvy oil SP 3700 84/ 3586-3600 500 A S/ 3bwph & SSO S/ 4 bfph

J. G. McGEHEE

Drlg. Data

16/ 3614-18 S/ 5 bfph 20% oil

500 A S/ 7 $\frac{1}{2}$ bw $\frac{1}{2}$ bswph

SP 3650 40/ 3476-86 340218453-63

500 A S/ .sw 16/ 35022087 1 $\frac{1}{2}$ bswph

500 A 22 bswph DD 4113 3000 A

Comp. For SWD well

8961 91 NTC