


Graham

KANSAS

SECTION 9 TOWNSHIP 10S RANGE 25W

WELL NO. #1 Reidel

COMPANY Empire Drlg. & R.W. Shields

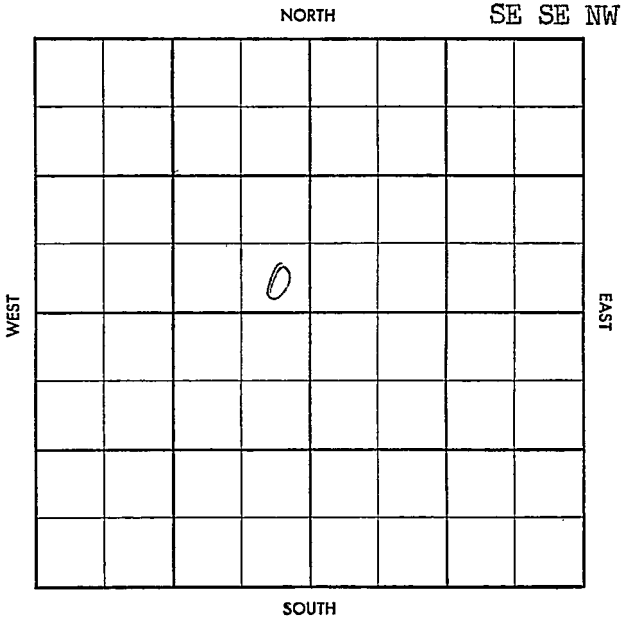

CO. Graham ELEV. 2539

OCT 30 '57

SEC. 9 TWP. 10 RGE. 25W

COMPANY Empire Drlg. NO. 1 COMPLETE
& P. W. Shields

FARM Reidel

LOC. NCPA - DHM SF SF N^o CRA - AC

Ah 2159
H 3772
TR 3796
LS9 3812
TD 4050

GEOL. _____
 CONTR. Empire Drlg.
 POOL oil cont.
 SPUD 7-19-57
 8" 213 drlg. 3012
 DST 3780-3805 1hr
G/42" 2160' oil 120'
HOCM FP 160-880
BHP 1300/30 DST
3405 - 30 30" 10'M

FPD BHP 1260th Running DST 3834-48
1hr G/37" 1230' 9599 0 + 120' HOCM
FP 100 - 440 BHP 1240/30" DST
3855-70 1hr 595 SW BHP 1060/30
DST 3942 - 60 1hr G/21" 450" +
60' OCM FP 100 - 400 BHP 1360/30"
DST 3978 - 4005 1 1/2 hrs 370'
GIP 140 OCM FP 0-50
BHP ~~100~~ 800/30 DST 4019-30
30" 6" M FPD BHP 0

52x4049/100 WOC

Log tops H 3772

TR 3796 L 3812 BKC 4046

CO 24/4015-21 350' oil

Net 31 8 25 BOPH 2 hrs

tsg 00 10 57 15 BOPH 6 hrs

POP 01 23 57 P 17680 NW 22 hr

WOP STATE TEST
P 265 BO NW

GR 350