


Graham


KANSAS

SECTION 9 TOWNSHIP 10S RANGE 25W

WELL NO. #1 Reidel "B"

COMPANY Empire Drlg. & NCRA

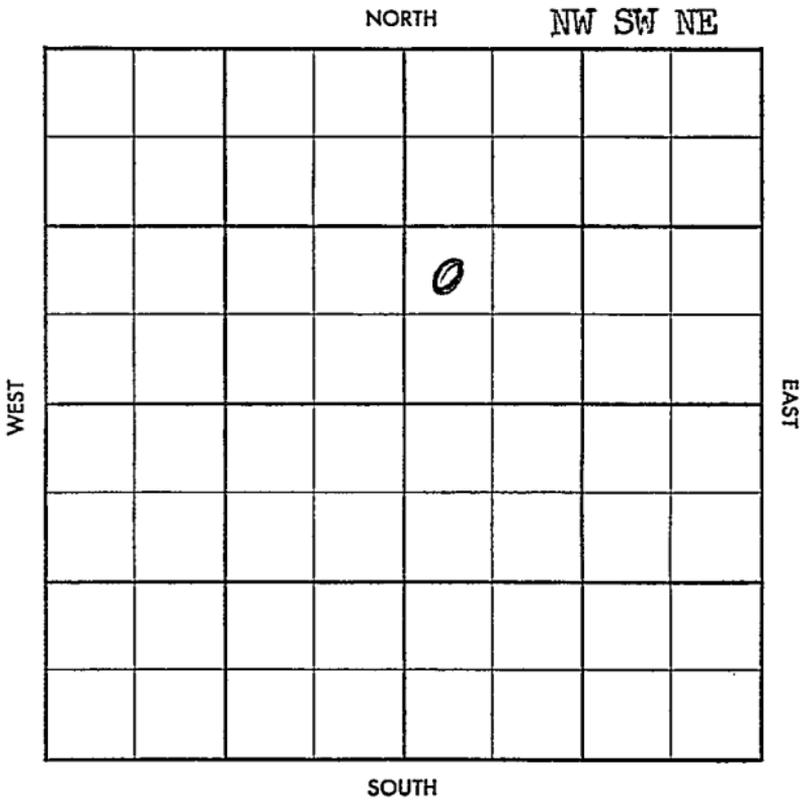

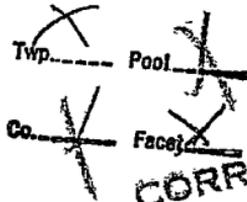

CORRECTION

S-513-A

CO. Graham ELEV. 2508²⁰
 SEC. 9 TWP. 10 RGE. 25W
 COMPANY Empire Drig. NO. 1 **COMPLETE**
 FARM Reidel "B"
 LOC. NW SW NE

A 2133
H 3739
TR 3767
L 3784
DST 3775-95
TD 4010

GEOL. _____
 CONTR. Co. Tools _____
 POOL Elrick NW
 SPUD 1-15-58
 Location JAN 22 '58 8"
167/115 3550
JAN 23 '58 DST 3746-
75 60" 720'
MSW FPO-400
BHP 1120/30 DST
3775-9530" 4' WM FPO BHP
1160/30 DST 3804-26 60"
185' SW FPO-120 BHP 1308/30
DST 3910-30 60" 3015 gip
55' OCM 230' oil FPO-120
BHP 1400/30 DST 3951-75
90" 450' gip 90' OCM 30'
SW OCM FPO BHP 1340/45
3972-4040 60" 90' OCM 60"
WM 240 SW FPO 110-260 BHP

760/30" 5" 4009/75 WCT
FEB 5 '58 24/3966-72 5 1/2
Boph NT ~~500~~ (3) \$27 Boph
5 hrs 500' OB POP FEB 12 '58
FEB 19 '58 MAR 5 '58 MAR 12 '58 MAR 19 '58
MAR 26 '58 APR 2 '58 APR 9 '58 APR 16 '58 P 4 Boph
NT Dec PB 3950 24/3922
-28 \$5.00 4 hrs (3) \$40 Boph
NW 8 hrs 2200' OB POP
APR 23 '58 Phy P 215 BO NW
Lsg 3922-28

CO.
LSE
NO.
SEC.
TWP.
RGE.