


Section 9 Township 10 Range 27W

Well No. #1 Zerr

Company Victor Drlg.

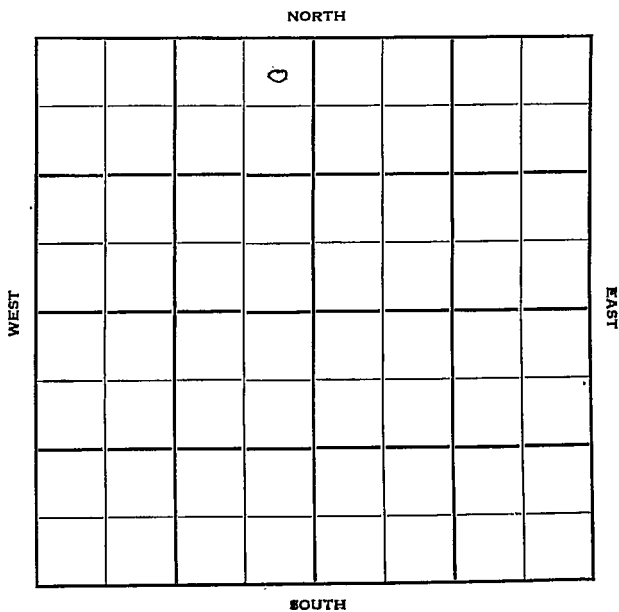

Sheridan

KANSAS

Sec. 9 **HOT FILE** 10 R. 27W

Well No. #1 Zerr Farm

Victor Drlg. Company

Victor - Contr. Contractor

Wildcat


330' Ft. from N. Line

Ft. from S. Line

330' Ft. from E. Line

Ft. from W. Line

NE NE NW

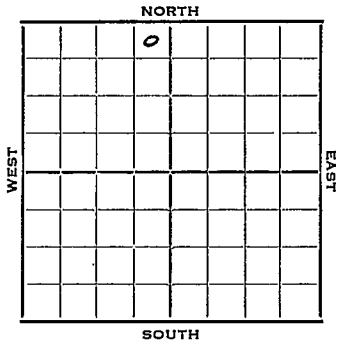

1952 Elev. 2694' REPORT

4/16 MI
 4/23 Drlg. 1168'
 8" @ 815'
 4/30 Anhy 2290 Drlg. 3420'
 5/7 Topeka 3627 Heeb. 3816
 Tor. 3835 Lans. 3852
 DST 3900-3936, 1/2 hr. 305' SO& ?trcm
 915' Smc SW 1600# FP 570#
 Miss Li 4431
 Drlg. 4490'
 5/14 Spud 4-18-52
 D&A TD 4680
 8" @ 815 Anhy 2290
 Top 3627 Heeb. 3816
 Tor. 3835 Lans. 3852
 DST 3900-3936 opn 1/2 hr. Rec. 305'
 so & wcm 915' smcsw Miss 4431
 Arb. 4534 TD 4680
 D&A

ABANDONED

County Sheridan State Kansas

Sec. 9 (Blk. Twp.) 10 (Sur. Rge.) 27W Map No.

Operator Victor Drlg.

Well No. 1 Farm Zerr

Elev. 2694 Location NE NE NW

330 Ft. From N Line NW

330 Ft. From E Line Quarter

1st. Report

Completion MAY 14 1952

Remarks Wildcat

Victor Drlg. - Contr.

Spudding Date 4-18-52

Drlg. Data D & A TD 4680

8" @ 815 Anhy 2290 Top. 3627

Heeb. 3816 Tor. 3835 Lans. 3852

DST 3900-3936 open 1/2 hr. Rec. 305' so

& wcm 915' smcsw Miss. 4431

Arb. 4534 TD 4680

D & A