

DX 78-1

Rooks

KANSAS

Section 9 Township 10 S Range 18 W

Well No. # 2 E. C. Ordway

Company Midstates Oil Corp.

NORTH

WEST

EAST

	0						

SOUTH

12

Rooks

KANSAS

SEC.	TWP.	R.
9	10 S	18 W
WELL NO.		
# 2 E. C. Ordway		FARM
COMPANY		
Midstates Oil Corp.		
CONTRACTOR		

Williams


990 Ft. from N. Line

Ft. from S. Line

Ft. from E. Line

990 Ft. from W. Line


SE NW SW

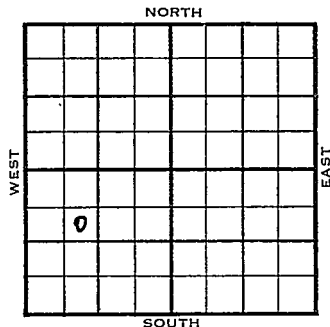

1954	ELEVATION 2185'	REPORT
12/8	Location	
1955 2/9	Spud 12-22-54 Oil Well TD 3764' Anhy 1582' 8" @ 1593' Top 3154', Heeb 3373' Tor 3389' DST 3378'-3402' opn 1 hr, rec 60' so & gcm, 100' ho & gcm, 80' smcgo 870# Lans 3417' DST 3465'-85' opn 1/2 hr, rec 15' Mud 50# DST 3595'-3615' opn 1 hr, rec 170' ms 780# Cong 3659' Simp 3722' DST 3723'-41' opn 1 hr, rec 20' Mud 35# Arb. 3750' TD 3764' 5" @ 3575' LogTops: Top 3154' Heeb 3370', Tor 3386' Lans 3412' TD 3540' 35/ 3386-92 B/ 22 go 2 gw 1/2 hr. B/ 18 go 1/2 hr. 500 A S/ 5.3 boph 7 hr. P/ 80 bo 16 hr. Comp 47 bopd.	

FABEN GILSTRAP

County Rooks State Kansas
 Sec. 9 (Bk.) (Twp. 10) (Sur.) (Rge. 18W) Map No.
 Operator Mid-States Oil Corp.
 Well No. 2 Farm E. C. Ordway
 Elev. 2185 Location SE NW SW

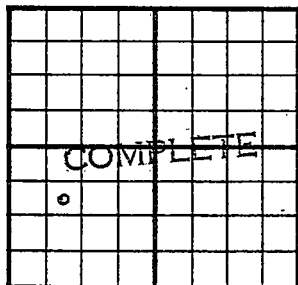

990 Ft. From N Line SW
990 Ft. From W Line Quarter
 Ist. Report
 Completion FEB 9 1955
 Remarks Williams Pool
 Spudding Date 12-22-54

Drlg. Data Oil well TD 3764
Anhy 1582 8" @ 1593 Top. 3154
Heeb. 3373 Tor. 3389 DST 3378-3402
open 1 hr. Rec. 60' so & gcm 100' ho &
gcm 80' smcgo 870# Lans. 3417
DST 3465-85 open $\frac{1}{2}$ hr. Rec. 15' mud
50# DST 3595-3615 open 1 hr. Rec.
170' msw 780# Cong. 3659 Simp. 3722
DST 3723-41 open 1 hr. Rec. 20' mud
35# Arb. 3750 TD 3764 5" @ 3575
 LOG TOPS:
Top. 3154 Heeb. 3370 Tor. 3386
Lans. 3412 TD 3540 35/ 3386-92
B/ 22 go 2 gw $\frac{1}{2}$ hr. B/ 18 go $\frac{1}{2}$ hr.
500 A S/ 5.3 boph 7 hr. P/ 80 bo 16 hr.
 Comp. 47 bopd

FABEN GILSTRAP