FORM 51


Rooks

KANSAS

Section 9 Township 10 Range 18W

Well No. #2 Williams

Company Mid-States Oil

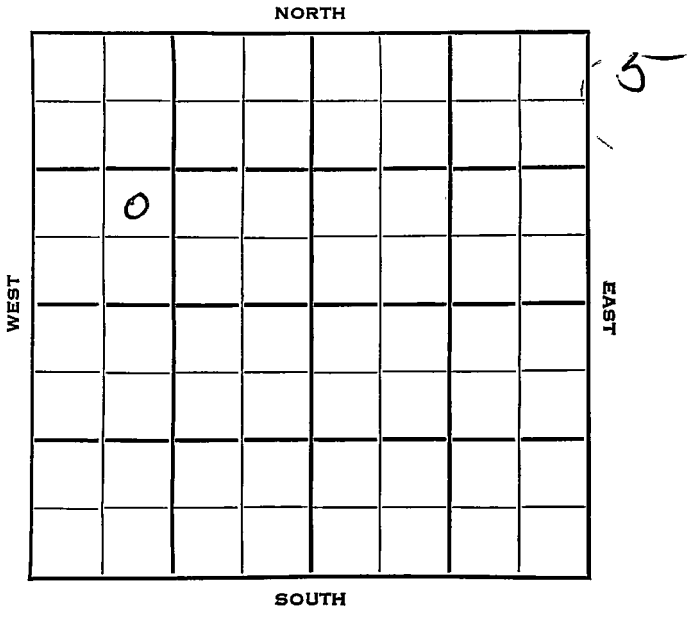

FORM 252-B
10M 10-50 PETROL

Rooks KANSAS

Sec. 9 Twp. 10 R. 18W

Well No. #2 Williams Farm

Mid-States Oil Company

Barnett Drlg. Contractor

Williams Pool


990 Ft. from N. Line

990 Ft. from S. Line

Ft. from E. Line

990 Ft. from W. Line

NE SW NW

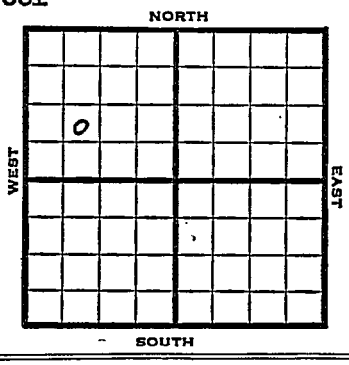

1953	Elev. 2190' REPORT
4/29	MIR
5/6	Drlg. 1570'
5/21	Pipe stuck
5/28	N.R.
6/3	"
6/24	"
7/8	Spud 5-1-53 Oil Well TD 3763' 8" @ 1576' Anhy 1569, Top 3152, Heeb 3369, Tor. 3387 DST 3376-3401 opn 1 hr, rec 80' hocm 10' socm 820# Lans 3412. DST 3401-20 failed. DST 3401-20 opn 1 hr, rec 5' mud 35# DST 3456-80 opn 1½ hr, rec 60' hocm 90# SW 832# DST 3489-3500 opn 1 hr, rec 273' vhmco 210' sw 1085# DST 3556-85 opn 1½ hr, rec 50' mud, 120' vsocm 832# DST 3647-72 opn ½ hr, rec 5' mud 65# Cong 3646, Simp 3708, DST 3707-13 opn 3/4 hr, rec 3' mud DST 3724-37 opn 1 hr, rec 50' hocm 300' mud

OVER

1953

Information brought forward.

7/8 DST 3732-39 opn 3/4 hr, rec 5' mud 0#
DST 3737-47 opn ½ hr, rec 2' mud 0#
Arb 3752
DST 3741-54 opn 1 hr, rec 50' socm 410#
DST 3753-56 opn 1 hr, rec 10' mud, 0#
DST 3754-60 opn 1 hr, rec 33' mud, 968#
DST 3756-63 opn 1 hr, rec 250' sw 1075#
5" @ 3753'
TD 3763'
CO to 3763'
7 gwph 250 A S/ 27 bfph 6 hr. S/ 162 bsw 10 goph 6 hr. SP 3675
18/ 3495-98 S/ 4 gwph 500 A S/ 69 bw 3½ boph 3 hr. S/ 41 bw 8 boph SP 3480 24/ 3468-72 S/ dry 250 A S/ 6 bo 69 bwph
CO to 3675
P/ 348 bw 45 bopd
Comp. 80 bopd 320 bw.

COMPLETED

FORM 275 FOR SALE BY KANSAS BLUE PRINT CO.


County Rooks State Kansas

Sec. 9 (Blk. Twp.) 10 (Sur. Rge.) 18W Map No.

Operator Mid-States Oil

Well No. 2 Farm Williams

Elev. Location NE SW NW

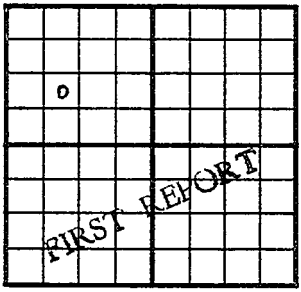

990 Ft. From S Line NW

990 Ft. From W Line Quarter

1st. Report APR 29 1953

Completion

Remarks Barnett Drlg. - Contr.

Spudding Date

Drlg. Data Williams Pool

MIR

J. G. McGEHEE

FORM 275 FOR SALE BY KANSAS BLUE PRINT CO.


County Rooks State Kansas

Sec. 9 (Blk. Twp.) 10 (Sur. Rge.) 18W Map No.

Operator Mid-States Oil

Well No. 2 Farm Williams

Elev. 2190 Location NE SW NW

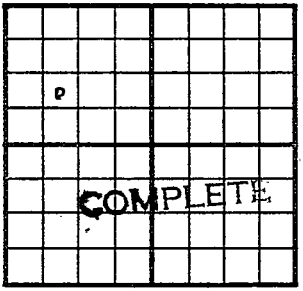

990 Ft. From S Line NW

990 Ft. From W Line Quarter

1st. Report

Completion JUL 8 1953

Remarks Williams Pool

Barnett Drlg. - Contr.

Spudding Date 5-1-53

Drlg. Data Oil well TD 3763

8" @ 1576 Anhy 1569 Top. 3152

Heeb. 3369 Tor. 3387 DST 3376-3401

open 1 hr. Rec. 80' hocm 10' socm 820#

Lans. 3412 DST 3401-20 failed DST 3401-

20 open 1 hr. Rec. 5' mud 35#

DST 3456-80 open 1½ hr. Rec. 60' hocm

90# sw 832# DST 3489-3500 open 1 hr.

Rec. 273' vhmco 2103 sw 1085#

DST 3556-85 open 1½ hr. Rec. 50' mud

10' vsocm 832# DST 3647-72 open ½ hr.

Rec. 5' mud 65# Cong. 3646 Simp. 3708

DST 3707-13 open 3/4 hr. Rec. 3' mud

DST 3724-37 open 1 hr. Rec. 50' hocm

300' mud DST 3732-39 open 3/4 hr.

J. G. McGEHEE

Drlg. Data

Rec. 5' mud 0# DST 3737-47 open ½ hr.
Rec. 2' mud 0# Arb. 3752 DST 3741-54
open 1 hr. Rec. 50' scom 410#
DST 3756-56 open ½ hr. Rec. 10' mud
0# DST 3754-60 open 1 hr. Rec. 33' mud
9[illegible]# DST 3756-63 open 1 hr. Rec. 250'
sw 1075# 5" @ 3753 TD 3763 CO to 3763
7 gwph 250 A S/ 27 bfph 6 hr. S/ 162
bsw 10 goph 6 hr. SP 3675
18/ 3495-98 S/ 4 gwph 500 A S/ 69 bw
3½ boph 3 hr. S/ 41 bw 8 boph
SP 3480 24/ 3468-72 S/ dry 250 A
S/ 6 bo 69 bwph CO to3675
P/ 348 bw 45 bopd
Comp. 80 bopd 320 bw