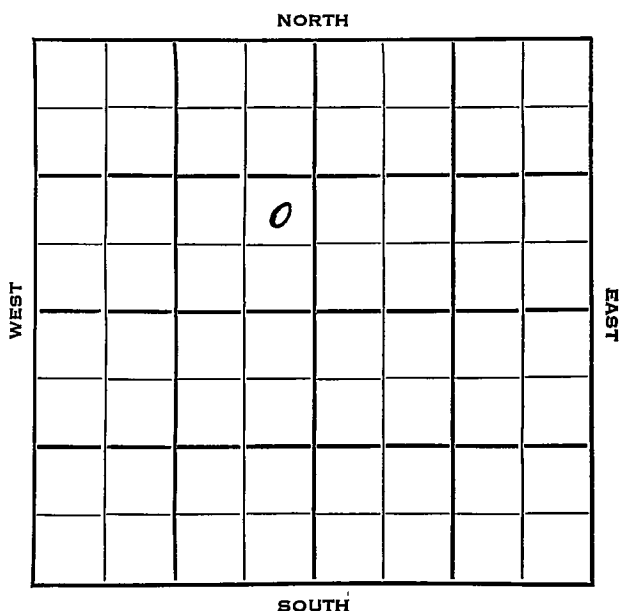


Section 9 Township 10 Range 19 WWell No. # 1 Baldwin "A"Company Grant Oil

Sec. 9 Twp. 10 R. 19WWell No. #1 Baldwin "A" Farm

Grant Oil

Company

Trans-Era

Contractor

NWVohs Pool

Ft. from N. Line

990


Ft. from S. Line

330

Ft. from E. Line

Ft. from W. Line

NE SE NW

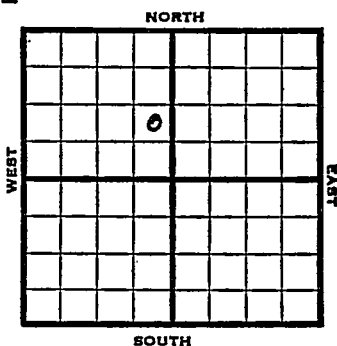

1953

Elev. 2205' REPORT

5/27

Spud 5-20-53

8" @ 160'

Anhy 1590'

Drlg 2955'

6/3

Top 3185, Heeb 3397, KC 3435, Cong 3674, Simp dol 3714, Arb 3744

TD 3750'

5" @ 3744'

DST 3745-50 1 hr, 20' oil, 50' ocw 700#

6/10

Spud 5-20-53

D & A

TD 3750'

8" @ 160'

Anhy 1590', Top 3185, Heeb 3397, KC 3435, Cong 3674, Simp 3714, Arb 3744,

TD 3750'

5" @ 3744'


DST 3745-50 opn 1 hr, rec 20' oil, 50' ocw 700#

GO to 3750'

SSO & SSW 500 A S/ 20 go 20 bwph D & A

ABANDONED

County Rooks State Kansas
 Sec. 9 (Blk. 10 (Sur. 19W Map No.
 (Twp.) (Rge.)
 Operator Grant Oil
 Well No. 1 Farm Baldwin "A"
 Elev. Location NE SE NW

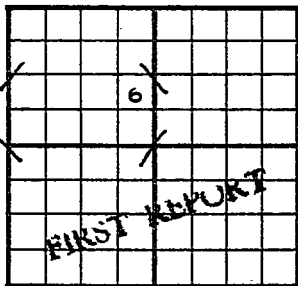


990 Ft. From S Line NW
330 Ft. From E Line Quarter
 1st. Report MAY 27 1953
 Completion
 Remarks
Trans-Era - Contr.
 Spudding Date 5-20-53

Drlg. Data NW Vohs Pool
8" @ 160 Anhy 1590 drlg. 2955

J. G. McGEHEE

County _____ Rocks _____ State Kansas
 Sec. 9 (Blk. 10 (Sur. 19W Map No. _____
 (Twp.) (Rge.)
 Operator Grant Oil
 Well No. 1 Farm Baldwin "A"
 Elev. 2205 Location NE SE NW

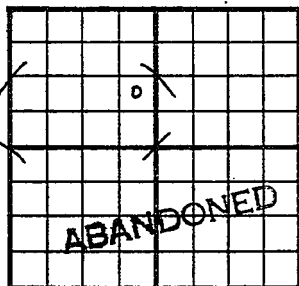

990 Ft. From S Line NW
330 Ft. From E Line Quarter

1st. Report

Completion JUN 1 0 1953

Remarks NW Vohs Pool
Trans-Era - Contr.

Spudding Date 5-20-53

Drig. Data D & A TD 3750

8" @ 160 Anhy 1590 Top. 3185

Heeb. 3397 KC 3435 Cong. 3674

Simp. 3714 Arb. 3744 TD 3750

5" @ 3744 DST 3745-50 open 1 hr.

Rec. 20' oil 50' ocw 700# CO to 3750

SSO & SSW 500 A S/ 20 go 20 bwph

D & A

J. G. McGEHEE