


Section 9 Township 10 Range 19W

Well No. 1 Henderson

Company Harber et al

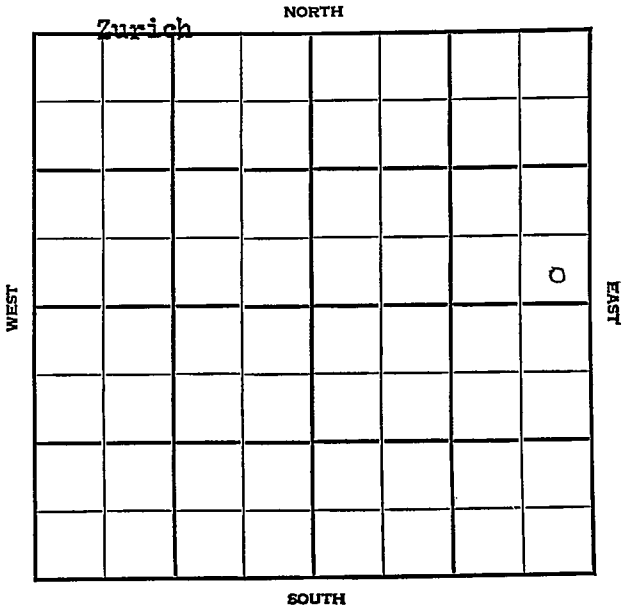

MINNAPAS  
 10

Rooks

Sec. 9 Twp. 10 R. 19W

Well No. #1 Henderson Farm

Harber et al Company

Zurich


\_\_\_\_\_ Ft. from N. Line

330 Ft. from S. Line

330 Ft. from E. Line

\_\_\_\_\_ Ft. from W. Line

SE NE

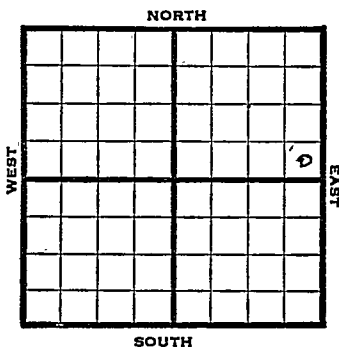

1947

Elev. 2202' REPORT

10/1 10" @ 169'

WOC

10/8 Drlg. 2980'

10/14 Lansing 3429' -  
 Conglomerate 3675' TD

TD3782' in Cong.

5" @ 3645'

RUST

10/22 TD 4198'

10/29 TD 3782'  
 48 shots 3462-76 - 500 acid

Water squeeze

24 shots 3470-76

No show

11/5 "

11/12 Plug 3485'  
 48 shots 3464-70'

11/19 Squeeze

11/25 "

12/3 "

12/10 "

OVER

1947

12/23

Congl. 3675'

5" @ 3674'

3782' in Cong.

TD 3782'

ABANDONED

Map No. \_\_\_\_\_ Sec. 9 Twp. 10 R. 19W

Well No. 1 Henderson

Harbar etal. \_\_\_\_\_ Company

FIRST REPORT

Contractor

SE NE

\_\_\_\_\_ Ft. from N. Line  
330 \_\_\_\_\_ Ft. from S. Line  
330 \_\_\_\_\_ Ft. from E. Line  
\_\_\_\_\_ Ft. from W. Line

SECTION PLAT


Rooks County

Location \_\_\_\_\_

Rig up \_\_\_\_\_

Drilling and Remarks:

10" @ 169 WOC

RECORD

Cased \_\_\_\_\_ in, \_\_\_\_\_ ft.

Sand \_\_\_\_\_

Gas \_\_\_\_\_

Oil \_\_\_\_\_

Total Depth \_\_\_\_\_

PRODUCTION

1st 24 hrs. Nat. \_\_\_\_\_

1st 24 hrs. after shot \_\_\_\_\_

Gas \_\_\_\_\_ Cu. Ft.

Dry Hole \_\_\_\_\_

Abandoned \_\_\_\_\_

Date

OCT 1 1947 19

S. J. LEWIS Scout

