

KANSAS

Rooks County

FORM 51 5M PETROL

Section 9 Township 10 Range 20W

Well No. 1 Hindhouse "B"

Company Bridgeport

NORTH

SOUTH

WEST

EAST

15

0

KANSAS

Rooks

Sec. 9 Twp. 10 R. 20W

Well No. 1 Hindhouser "B" Farm

Bridgeport. Company

Wildcat

Ft. from N. Line

330

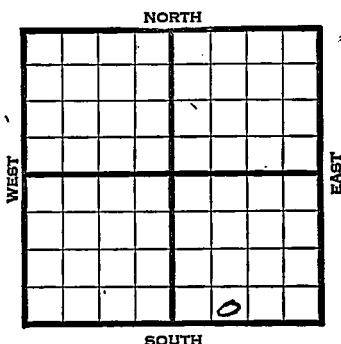
Ft. from S. Line

Ft. from E. Line

990

Ft. from W. Line

SE SW SE



1945

Elev. 2186

REPORT

6/27

RUR

6/3

8" @ 210

7/11

Drilg. 2295'

Topeka 3240'

Heebner 3431

Lans 3474

Drilg. 3569'

7/18

Simp 3805

Arb. 3814

TD 3850'

ABANDONED

Kansas Pool Name WildcatMap No. 65 Sec. 9 Twp. 10 R. 20WWell No. 1 Hindhouse "B"Bridgeport

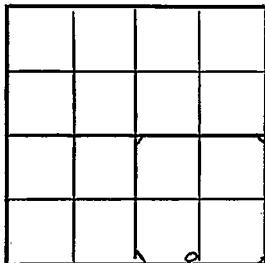
Company

FIRST REPORT

Contractor

SE SW SE

SECTION PLAT

 Ft. from N. Line330 Ft. from S. Line Ft. from E. Line990 Ft. from W. LineRooks CountyLocation Rig up

Drilling and Remarks:

RUR

RECORD

Cased in., ft.Sand Gas Oil Total Depth

PRODUCTION

1st 24 hrs. Nat. 1st 24 hrs. after shot Gas Cu. Ft.Dry Hole Abandoned

Date

JUN 27 194519S. J. LEWIS

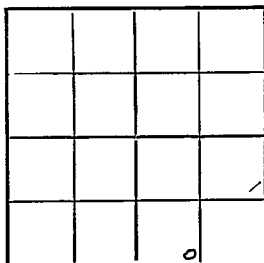
Scout

KANSASPool Name WildcatMap No. 60 Sec. 9 Twp. 10 R. 20WWell No. 1 Hindhouse "B"Bridgeport

Company

ABANDONED
SE SW SE

Contractor

E 12186
SECTION PLAT Ft. from N. Line330 Ft. from S. Line Ft. from E. Line990 Ft. from W. LineRooks County**RECORD**Location Cased in., ft.Rig up Sand

Drilling and Remarks:

Gas Oil Total Depth 2850**PRODUCTION**1st 24 hrs. Nat. 1st 24 hrs. after shot Gas Cu. Ft.Dry Hole Abandoned

Date

JUL 1 8 1945 19S. J. LEWIS

Scout