

Sec. 9 Twp. 10 R. _____

Well No. #1 Rode Farm _____

Heathman Drlg. Company _____


Contractor _____

Palco SE
990' Ft. from N. Line

_____ Ft. from S. Line

990' Ft. from E. Line

_____ Ft. from W. Line

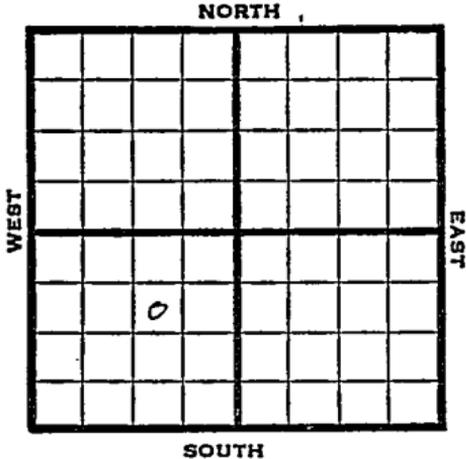

SW NE SW

1950 Elev. 2233' REPORT

4/12 8" @ 128'
Anhy 1722'
Drlg. 2890'

4/19 TD 3889'
8"@ 128'
Anhy 1722'
Topeka 3274'
Heeb 3479'
KC 3519'
BKC 3743'
Gong 3781'
Arb. 3843'
D&A
A band.

ABANDONED

Kansas

Map No. _____ Sec. 9 Twp. 10 R. 20W

Well No. 1 Rode

Heathman Drlg. Company

Contractor

SW NE SW


E 1.2233
SECTION PLAT

990 Ft. from N. Line

_____ Ft. from S. Line

990 Ft. from E. Line

_____ Ft. from W. Line

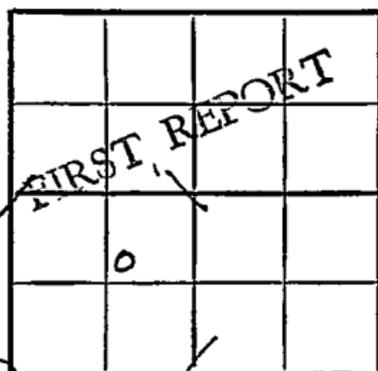

Rooks County

Location _____

Rig up _____

Drilling and Remarks:

8" @ 128

Anhy 1722

drlg. 2890

RECORD

Cased _____ in., _____ ft.

Sand _____

Gas _____

Oil _____

Total Depth _____

PRODUCTION

1st 24 hrs. Nat. _____

1st 24 hrs. after shot _____

Gas _____ Cu. Ft.

Dry Hole _____

Abandoned _____

Date

APR 12 1950

19

J. E. TYRA Scout

Kansas

Palco SE

Map No. _____ Sec. 9 Twp. 10 R. 20W

Well No. 1 Rode

Heathman Drlg. Company

Contractor

SW NE SW


FL 2233
SECTION PLAT

990 Ft. from N. Line

_____ Ft. from S. Line

990 Ft. from E. Line

_____ Ft. from W. Line

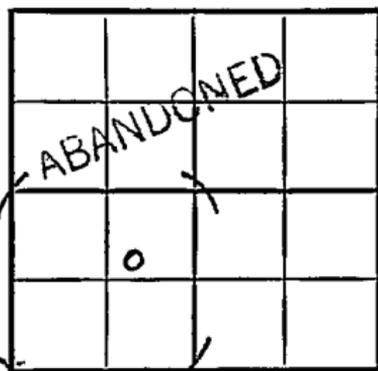

Rooks County

Location _____

Rig up _____

Drilling and Remarks:

8' @ 128
Andy 1722
Jopha 3274
Rub 3479
K.C. 3519
BKC 3743

RECORD

Cased _____ in., _____ ft.

Sand _____

Gas _____

Oil _____

Total Depth 3889

PRODUCTION

1st 24 hrs. Nat. _____

1st 24 hrs. after shot _____

Gas _____ Cu. Ft.

Dry Hole _____

Abandoned _____

Lang 3781
Date *and 3843*

DVA

APR 19 1950 19

J. E. TYRA

Scout