

Rooks

Section 9 Township 10 Range 20WWell No. #2 RodeCompany Heathman Drlg.

NORTH

WEST

EAST

0							

SOUTH

13

Rooks

KANSAS

Sec. 9 Twp. 10 R. 20W 

Well No. #2 - Rode Farm

¹¹
Heathman Drlg.

Company

B & B

Contractor

Amboy Pool


Ft. from N. Line

330' Ft. from S. Line

Ft. from E. Line

330' Ft. from W. Line

SW SW SW

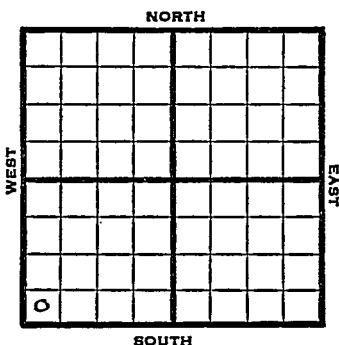

1950

Elev. 2227'

REPORT

4/26

Spud 4-21-50
8-5/8" @ 185'
Anhy 1708'
Drlg. 2250'

6/7

8-5/8" @ 185'
Heeb 3462'
Lans 3503'
Cong 3759'
Simp 3774'
Arb. 3791'
5" @ 3791'
P 178 BOPD
TD 3817'

COMPLETED

Kansas


Amboy Pool

Map No. _____ Sec. 9 Twp. 10 R. 20WWell No. 2 Rode

Heathman Drlg. _____ Company

B & B _____ Contractor

SW SW SW

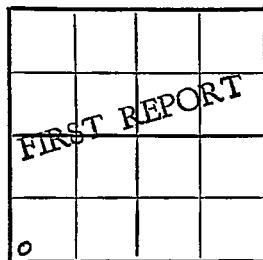E1. 2227
SECTION PLAT

_____ Ft. from N. Line

330 Ft. from S. Line

_____ Ft. from E. Line

330 Ft. from W. Line

Rooks County

Location _____

Rig up _____

Drilling and Remarks:

Spud 4-21-50

8 5/8" @ 185

Anhy 1708

drlg. 2250

RECORD

Cased _____ in., _____ ft.

Sand _____

Gas _____

Oil _____

Total Depth _____

PRODUCTION

1st 24 hrs. Nat. _____

1st 24 hrs. after shot _____

Gas _____ Cu. Ft.

Dry Hole _____

Abandoned _____

Date

APR 26 1930 19

J. E. TYRA
Scout

Kansas

Map No. _____ Sec. 9 Twp. 1C R. 20WWell No. 2 RodeHeathman Drlg. CompanySW SW ST ContractorEl. 2227
SECTION PLAT Ft. from N. Line330 Ft. from S. Line Ft. from E. Line330 Ft. from W. Line

COMP	ETE		

Rocks

Location _____

Rig up _____

Drilling and Remarks:

85" @ 185
 Keel 3462
 Lens 3303
 Cong 3759
 Simp 3774
 Carb 3791

5' @ 3791

Date

P 178 BOPD

RECORD

Cased _____ in., _____ ft.

Sand _____

Gas _____

Oil _____

Total Depth ~~3277~~ 3817

PRODUCTION

1st 24 hrs. Nat. _____

1st 24 hrs. after shot _____

Gas _____ Cu. Ft.

Dry Hole _____

Abandoned _____

JUN 7 1950 19

J. E. TYRA

Scout