


Section 9 Township 10 Range 20-WWell No. #1 Veatch "A"Company Heathman Drlg.

NORTH

WEST

EAST

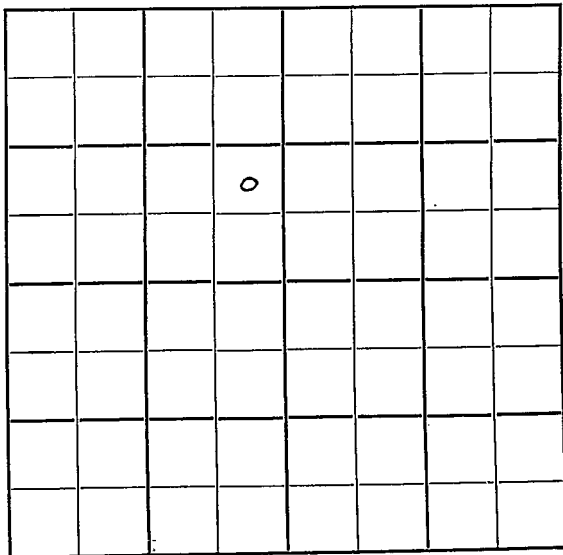

SOUTH

Rooks  
10

KANSAS

20W

Sec. 9 Twp. R.

Well No. #1 Veatch "A" Farm

Heathman Drlg. Company

Palco Pool Contractor


Ft. from N. Line

990' Ft. from S. Line

330' Ft. from E. Line

Ft. from W. Line

NE SE NW

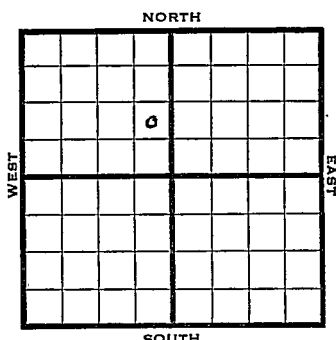

1950

Elev 2173

REPORT

7/5

Rig up

7/12

Spud 7-3-50

8" @ 180

Anhy 1669-1711

Heeb 3408

KC 3447

Cong 3733

TD 3820

D&A

**ABANDONED**

Kansas

Map No. \_\_\_\_\_ Sec. 9 Twp. 10 R. 20WWell No. 1 Veatch "A"

\_\_\_\_\_ Heathman Drlg. \_\_\_\_\_ Company

\_\_\_\_\_ Contractor


NE SE NW

\_\_\_\_\_ Ft. from N. Line

990 Ft. from S. Line330 Ft. from E. Line

\_\_\_\_\_ Ft. from W. Line

## SECTION PLAT

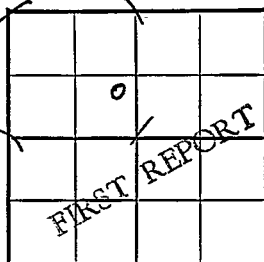

Rooks County

Location \_\_\_\_\_

Rig up X

Drilling and Remarks:

## RECORD

Cased \_\_\_\_\_ in., \_\_\_\_\_ ft.

Sand \_\_\_\_\_

Gas \_\_\_\_\_

Oil \_\_\_\_\_

Total Depth \_\_\_\_\_

## PRODUCTION

1st 24 hrs. Nat. \_\_\_\_\_

1st 24 hrs. after shot \_\_\_\_\_

Gas \_\_\_\_\_ Cu. Ft.

Dry Hole \_\_\_\_\_

Abandoned \_\_\_\_\_

Date

JUL 5 1950 19 J. E. TYRA Scout

Map No. \_\_\_\_\_ Sec. 9 Twp. 10 R. 20WWell No. 1 Veatch "A"

\_\_\_\_\_ Heathman Drlg. \_\_\_\_\_ Company

\_\_\_\_\_ Contractor


NE SE NW

E1. 2173  
SECTION PLAT

\_\_\_\_\_ Ft. from N. Line

990 Ft. from S. Line330 Ft. from E. Line

\_\_\_\_\_ Ft. from W. Line

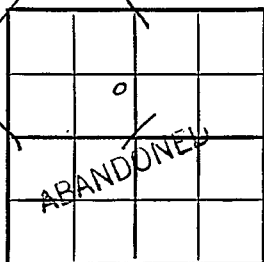

Rooks County

Location \_\_\_\_\_

Rig up \_\_\_\_\_

Drilling and Remarks:

Spud 7-3-50

8" C 180

Anhy 1669-3711

Heeb. 3408

KC 3447

Cong. 3733

TD 3820

## RECORD

Cased \_\_\_\_\_ in., \_\_\_\_\_ ft.

Sand \_\_\_\_\_

Gas \_\_\_\_\_

Oil \_\_\_\_\_

Total Depth 3820

## PRODUCTION

1st 24 hrs. Nat. \_\_\_\_\_

1st 24 hrs. after shot \_\_\_\_\_

Gas \_\_\_\_\_ Cu. Ft.

Dry Hole \_\_\_\_\_

Abandoned \_\_\_\_\_

Date D & AJUL 12 1930 19 J. E. TYRA Scout