


Section 9 Township 10 Range 20W

Well No. #1 Selina Veatch "A"

Company Heathman Drlg.

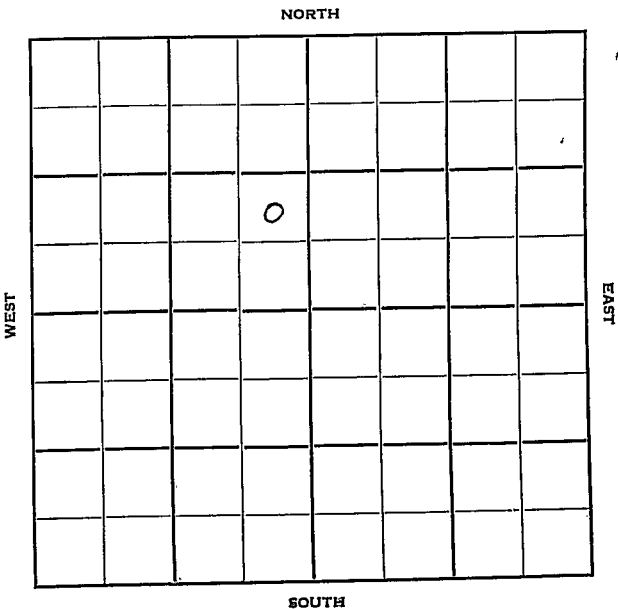

KANSAS

Rooks

Sec. 9 Twp. 10 R. 20-W

Well No. #1 Selina Veatch "A" Farm

Heathman Drlg Company


Contractor

 Ft. from N. Line

990 Ft. from S. Line

330 Ft. from E. Line

 Ft. from W. Line

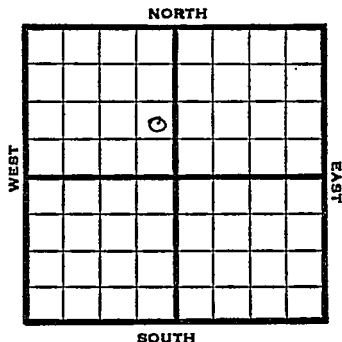

NE SE NW

1950

Elev 2173'

REPORT

2/1

MIM

2/8

TD 1711'

Abandoned and moved Location
Aband.

ABANDONED


Map No. _____ Sec. 9 Twp. 10 R. 2 OWWell No. 1 Selina Veatch "A"

_____ Heathman Drlg. _____ Company

_____ Contractor

NE SE NW

SECTION PLAT

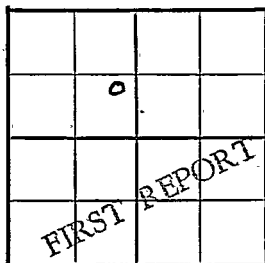

_____ Ft. from N. Line

990 Ft. from S. Line330 Ft. from E. Line

_____ Ft. from W. Line

Rooks County

Location _____

Rig up _____

Drilling and Remarks:

M I M

RECORD

Cased _____ in., _____ ft.

Sand _____

Gas _____

Oil _____

Total Depth _____

PRODUCTION

1st 24 hrs. Nat. _____

1st 24 hrs. after shot _____

Gas _____ Cu. Ft.

Dry Hole _____

Abandoned _____

Date


FEB 1 1950 19 J. E. TYRA Scout

Kansas

Palco Pool

Map No. _____ Sec. 9 Twp. 10 R. 20WWell No. 1 Selina - Veatch "A"_____
Heathman Drlg. _____ Company_____
NE SE NW _____ Contractor

NE SE NW

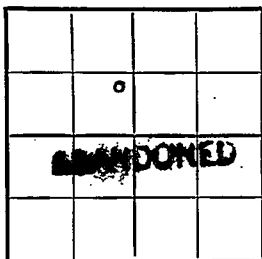E. 2173
SECTION PLAT_____
Ft. from N. Line990 Ft. from S. Line330 Ft. from E. Line_____
Ft. from W. Line

Rooks County

Location _____

Rig up _____

Drilling and Remarks:

T.D. 1711
abandoned
and moved
location.

RECORD

Cased _____ in., _____ ft.

Sand _____

Gas _____

Oil _____

Total Depth _____

PRODUCTION

1st 24 hrs. Nat. _____

1st 24 hrs. after shot _____

Gas _____ Cu. Ft.

Dry Hole _____

Abandoned _____

Date

FEB 8 1950J. E. TYRA Scout