


Section 9 Township 10 Range 20W

Well No. #2 Selina Veatch "A"

Company Heathman et al

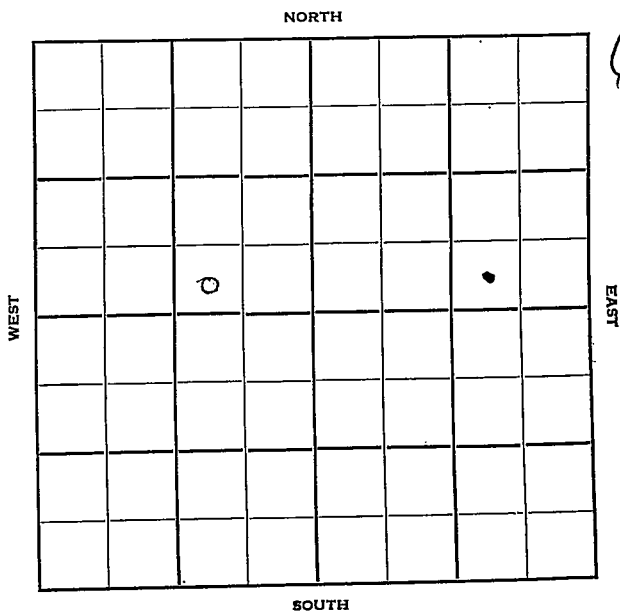

Sec. 9 Twp. 10 R. 20W

Well No. #2 Selina - Veatch "A" Farm

Heathman et al Company

Contractor

_____ Ft. from N. Line

330'


_____ Ft. from S. Line

990'

_____ Ft. from E. Line

_____ Ft. from W. Line

SW SE NW

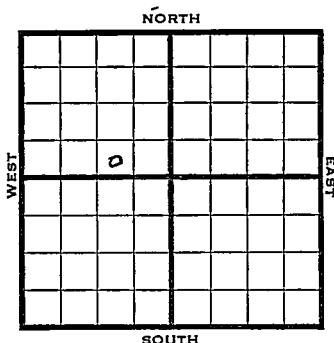

1950

Elev 2214' REPORT

2/8

Spud 2-4-50
8" @ 144'
Drlg. 1580'

3/22

8" @ 144'
Anhy 1711'
Topeka 3249'
Heebner 3452'
Lans 3490'
BKC 3714'
Cong 3742'
Simp 3759'
Arb. 3785'
5" @ 3787'
TD 3789'
500 acid
Swab 40 oil 3 hrs.
Comp 2647 BOPD
Comp

COMPLETED

Kansas

Map No. _____ Sec. 9 Twp. 10 R. 20WWell No. 2 Selina - Veatch "A"

_____ Heathman et al. Company

_____ Contractor


SW SE NW

E1. 2214
SECTION PLAT

_____ Ft. from N. Line

330 Ft. from S. Line990 Ft. from E. Line

_____ Ft. from W. Line

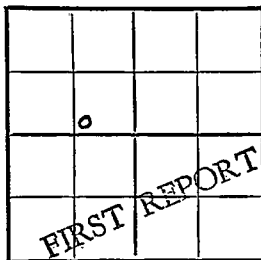

Rooks Courty

Location _____

Rig up _____

Drilling and Remarks:

Spud 2-4-50

8" @ 144

drlg. 1580

RECORD

Cased _____ in., _____ ft.

Sand _____

Gas _____

Oil _____

Total Depth _____

PRODUCTION

1st 24 hrs. Nat. _____

1st 24 hrs. after shot _____

Gas _____ Cu. Ft.

Dry Hole _____

Abandoned _____

Date

FEB 8 1950

19

J. E. TVRA Scout

Kansas

Map No. _____ Sec. 9 Twp. 10 R. 20W

Well No. 2 Selina - Veatch "A"

Heathman et al. Company

Contractor

SW SE NW

E1. 2214
SECTION PLAT


_____ Ft. from N. Line

330

_____ Ft. from S. Line

990 Ft. from E. Line

_____ Ft. from W. Line

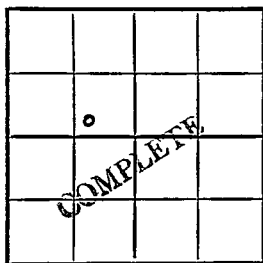

Rooks County

Location _____

Rig up _____

Drilling and Remarks:

8" @ 144
anhy 1711
Jopeta 3249
Hebner 3452
Lans. 3490
RKC 3714
Cong. 3742
Simp. 3759
and 3785

5" @ 3787

Date T.D. 3787

RECORD

Cased _____ in., _____ ft.

Sand _____

Gas _____

Oil _____

Total Depth _____

PRODUCTION

1st 24 hrs. Nat. _____

1st 24 hrs. after shot _____

Gas _____ Cu. Ft.

Dry Hole _____

Abandoned _____

MAR 22 1950 19

J. E. TYRA

Scout

500 acid
 Swab 40 oil 3 hrs.
 Camp. 26 47 bush

Misc.
Pierce Map
France Map
Tracings
Land Wall Map
Land Small Map
Scout Cards

6

MAR 30 1950

RECORDS

RECORDS

