


Section 9 Township 10 Range 20W

Well No. #4 Veatch

Company Heathman Drlg.

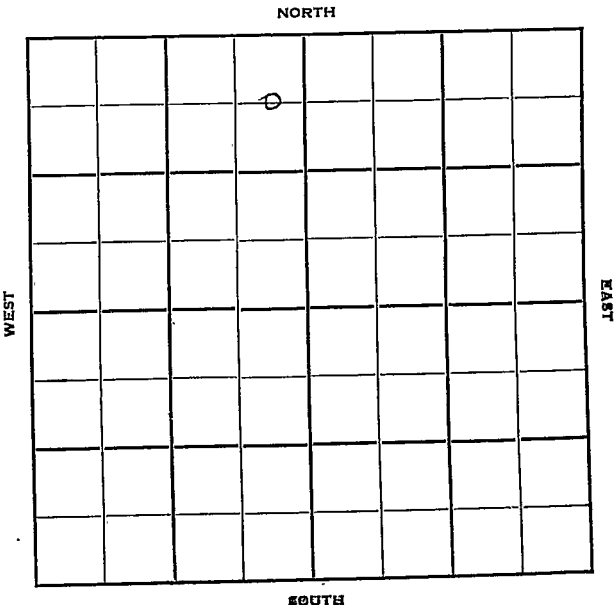

Rooks

KANSAS

Sec. 9 Twp. 10 R. 20^W

Well No. #4 Veatch Farm

Heathman Drlg. Company

Anschutz Drlg. -Contr. Contractor

Palco Pool


660' Ft. from N. Line

Ft. from S. Line

330' Ft. from E. Line

Ft. from W. Line

C E L N E N W

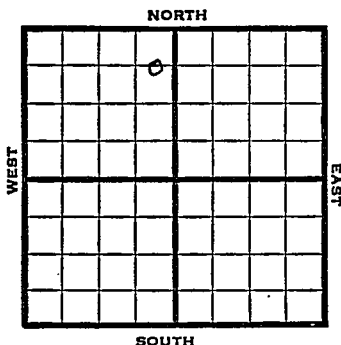

1950 Elev. 2176' REPORT

9/13 MIM

10/18 Spud 9-14-50
Oil Well TD 3757'
8-5/8" @ 115' Anhy 1667'
Top. 3205' Heeb 3406'
Lans. 3447' Cong. 3696'
Simp. 3721' Arb. 3742-45'
5" @ 3744'
FU 450' oil 3 hr DD 3752
S/3 1/2 BOPH 10 hr. 500 A
S/3 1/2 BOPH 4 hr DD 3757'
S/61 BO 3 hr Comp. 361 BOPD

COMPLETED

County Rooks State KansasSec. 9 (Blk. Twp.) 10 (Sur. Rge.) 20W Map No.Operator Heathman Drilg.Well No. 4 Farm VeatchElev. Location C E L NE NW

660 Ft. From N Line NW330 Ft. From E Line Quarter1st. Report SEP 13 1950


Completion

Remarks

Spudding Date

Drilg. Data Palco PoolM I M

J. E. TYRA

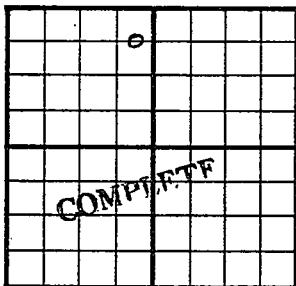County Rooks State KansasSec. 9 (Blk.
Twp.) 10 (Sur.
Rge.) 20W Map No.Operator Heathman Drlg.Well No. 4 Farm VeatchElev. 2176 Location C E L. NE NW660 Ft. From N Line NW330 Ft. From E Line Quarter1st. ReportCompletion OCT 18 1950Remarks SE Palco PoolAnschutz Drlg. - Contr.Spudding Date 9-14-50Drlg. Data Oil well TD 37578 5/8" @ 115 Anhy 1667 Top. 3205Heeb. 3406 Lans. 3447 Cong. 3696Simp. 3721 Arb. 3742-45 5" @ 3744FU 560' oil 3 hr. DD 3752 S/ 3 1/2 boph 10 hr.500 A S/ 3 1/2 boph 4 hr. DD 3757S/ 61 bo 3 hr. Comp. 361 boph

J. E. TYRA