

O.W.W.O.

KANSAS

Graham

Section 9 Township 10 Range 2W

Well No. 1 Teall

Company MB Armer & Atlantic

Moran
NORTH

				0			

WEST

EAST

SOUTH

KANSAS

Graham

✓ 21W ✓

Sec. 9 Twp. 10 R. 21W

Well No. #1 Teall Farm

M. B. Armer & Atlantic Company

Moran Pool


NORTH

330' Ft. from N. Line

_____ Ft. from S. Line

_____ Ft. from E. Line

330' Ft. from W. Line

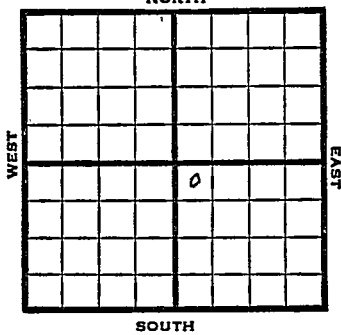

NW SE

1949

Elev. 2229' **R E P O R T**

- 4/6 RUR
- 4/12 8" @ 108'
Drlg 2370'
- 4/20 Lansing 3483'
Drlg 3609'
- 4/27 Arb. 3818'-20'
TD 3820'
SO
5" @ 3817'
- 5/4 TD 3822'
1000 acid
HFW
PB 3595'
34 shots 3528-34
500 acid
- 5/10 "
- 5/18 "
- 5/25 "
- 6/1 "
- 6/7 "
- 6/15 "
- 6/22 Lans. 3483'
Arb. 3818'
5" @ 3817'
Perf Lans
Pump 32 oil Pot.
Gr. 27°
TD 3822'

3818
 2229

 1589

COMPLETED

OVER

1952

O.W.W.O.

2/20 D&A TD 3690
Lans. 3487
Arb. 3817
OTD-3822
5" @ 3817
DP to 3800
18/3656-62 30/3675-85 500 A
S/1 boph 6 hr. 2000 A
S/14 bwph PB 3670 18/3656-62
B/14 Bwph DD 3690 S/3 bwph
12/3675-85 S/30 goph 250A
S/1 boph SSW 1000 A
S/96 bw 6 bo 12 hr.
D&A

FIRST REPORT
ABANDONED

3690
2229
1461

Map No. _____ Sec. 9 Twp. 10 R. 21WWell No. 1 TeallM. B. Armer Company

FIRST REPORT

Contractor

NW SE

SECTION PLAT

330 Ft. from N. Line

_____ Ft. from S. Line

_____ Ft. from E. Line

330 Ft. from W. Line

		o	

Graham County

Location _____

Rig up _____

Drilling and Remarks:

R U R

RECORD

Cased _____ in., _____ ft.

Sand _____

Gas _____

Oil _____

Total Depth _____

PRODUCTION

1st 24 hrs. Nat. _____

1st 24 hrs. after shot _____

Gas _____ Cu. Ft.

Dry Hole _____

Abandoned _____

Date

APR. 6. 1949 19S. J. LEWIS Scout

Kansas

Map No. K 65 Sec. 9 Twp. 10 R. 21WWell No. 1 (Teall)M. B. Armer Company**COMPLETE**

Contractor

NW SE

E 12229

SECTION PLAT

330 Ft. from N. Line

_____ Ft. from S. Line

_____ Ft. from E. Line

330 Ft. from W. Line

		o	

Graham County

RECORD

Location _____

Cased _____ in., _____ ft.

Rig up _____

Sand _____

Drilling and Remarks:

Gas _____

Lease 3483

Oil _____

Per 3518Total Depth 38225" C 3512

PRODUCTION

Per Lease

1st 24 hrs. Nat. _____

Pump 32 oil Per

1st 24 hrs. after shot _____

Gas _____ Cu. Ft.

Dry Hole _____

Abandoned _____

Date

JUN 22 1949 19S. J. LEWIS Scout

