

KANSAS

Graham

Section 9 Township 10 Range 21W

Well No. 1 Teal

Company M.B. Armer

Wildcat
NORTH

WEST

EAST

SOUTH

0

Graham

KANSAS



Sec. 9 Twp. 10 R. 21W

Well No. #1 Tea1 Farm

M. B. Armer

Company

Wildcat


990' Ft. from N. Line

 Ft. from S. Line

330' Ft. from E. Line

 Ft. from W. Line

SE NE SW

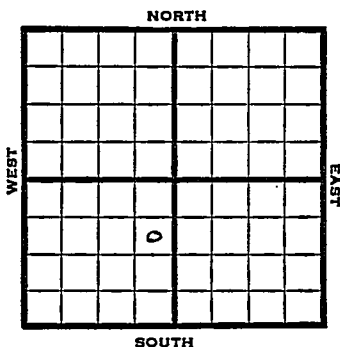

1949

REPORT

9/7 Location

9/14 "

9/21 "

9/28 Location

Aband.

ABANDONED

Map No. _____ Sec. 9 Twp. 10 R. 21W

Well No. 1 Teal

M. B. Armer Company

Contractor

SE NE SW


**FIRST REPORT
SECTION PLAT**

990 Ft. from N. Line

_____ Ft. from S. Line

330 Ft. from E. Line

_____ Ft. from W. Line

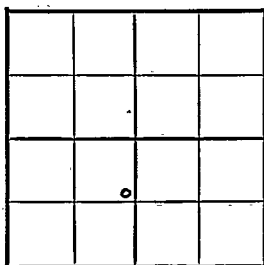

Graham County

Location X

Rig up _____

Drilling and Remarks:

RECORD

Cased _____ in., _____ ft.

Sand _____

Gas _____

Oil _____

Total Depth _____

PRODUCTION

1st 24 hrs. Nat. _____

1st 24 hrs. after shot _____

Gas _____ Cu. Ft.

Dry Hole _____

Abandoned _____

Date _____

SEP 7 1940 19

S. J. LEWIS Scout

Kansas

Map No. _____ Sec. 9 Twp. 10 R. 21WWell No. 1 Teal

M. B. Armer

Company

ABANDONED

Contractor

SE NE SW


SECTION PLAT

990 Ft. from N. Line

_____ Ft. from S. Line

330 Ft. from E. Line

_____ Ft. from W. Line

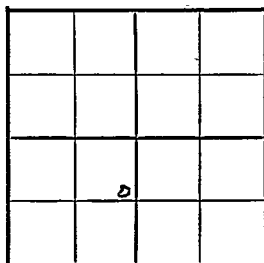

Graham County

RECORD

Location ✓

Cased _____ in., _____ ft.

Rig up _____

Sand _____

Drilling and Remarks:

Gas _____

Oil _____

Total Depth _____

PRODUCTION

1st 24 hrs. Nat. _____

1st 24 hrs. after shot _____

Gas _____ Cu. Ft.

Dry Hole _____

Abandoned _____

Date

SEP 28 1949

19

S. J. LEWIS

Scout