


Section 9 Township 10 I Range 22W

Well No. 1 Griffith

Company Barnett Drlg. et al

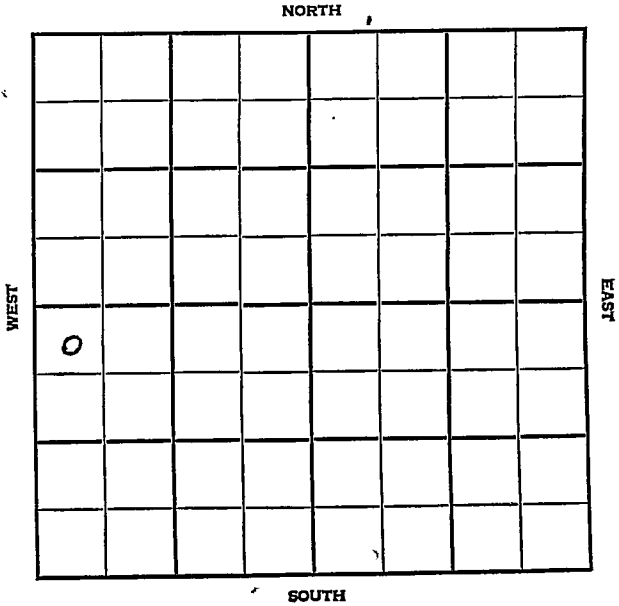

Graham

KANSAS

SEC.	TWP.	R.
9	10	22 W

WELL NO.

1 Griffith

FARM

COMPANY

Barnett Drlg. et al

CONTRACTOR

Co. tools

Wildcat


330 Ft. from N. Line

Ft. from S. Line

Ft. from E. Line

330 Ft. from W. Line

NW NW SW

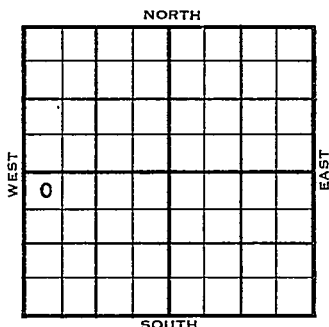

Cont'l. - Ac.

	ELEVATION	REPORT
1954	2285'	

10/13 Spud 10-9-54

8" @ 143

Drlg. 1985'

10/27 Spud 10-9-54 - D&A

TD 3820'

8" @ 143'

Heeb 3532', Lans 3570', B KC 3810'

TD 3820'

D&A

ABANDONED


County Graham State Kansas
 Sec. 9 (Blk. 10 (Sur. 22W Map No.
 (Twp.) (Rge.)
 Operator Barnett Drlg. etal.
 Well No. 1 Farm Griffith
 Elev. Location NW NW SW

FIRST REPORT

330 Ft. From N Line SW
330 Ft. From W Line Quarter
 Ist. Report OCT 13 1954
 Completion
 Remarks Cont'l - AC
Co. tools
 Spudding Date 10-9-54

Drlg. Data Wildcat
8" @ 143 drlg. 1985

FABEN GILSTRAP

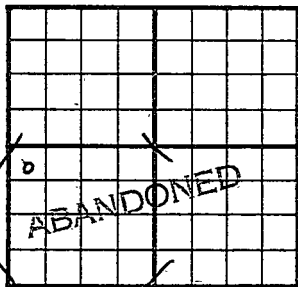County Graham State KansasSec. 9 (Blk.
Twp.) 10 (Sur.
Rge.) 22W Map No.Operator Barnett Drlg. etal.Well No. 1 Farm GriffithElev. 2285 Location NW NW SW330 Ft. From N Line SW330 Ft. From W Line Quarter1st. ReportCompletion OCT 27 1954Remarks WildcatCo. toolsSpudding Date 10-9-54Drlg. Data D & A TD 38208" @ 143 Heeb. 3532 Lans. 3570B KC 3810 TD 3820D & A

FABEN CH STRAD