

O.W.W.O.

Graham

KANSAS

SECTION 9 TOWNSHIP 10 RANGE 23 W

WELL NO. #6 Johnson "E"

COMPANY Birmingham & Bartlett

NORTH

WEST

EAST

						0	

SOUTH

Graham

KANSAS

SEC. 9	TWP. 10	R. 23W
-----------	------------	-----------

WELL NO.

#6 Johnson "E"

FARM

COMPANY

Birmingham & Bartlett

CONTRACTOR

Co. Tools

Hoof


Ft. from N. Line

Ft. from S. Line

Ft. from E. Line

Ft. from W. Line

NW NE SE

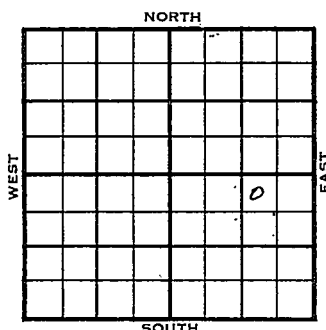

	ELEVATION	REPORT
1955	2405'	

11-30 Comm. 11-28-55

12-14 8 5/8" @ 248

DST 3697-3722 op 25 min. rec. 10' mud
500/30"

D & A

H. 3674

Tr. 3694

L. 3707

TD 3835'

ABANDONED

County Gravim Elev. _____
 Sec. 9 Twp. 10 Rge. 23W
 Company Birmingham & Bartlett
 Farm Name Johnson "E" No. 6

TOPS	DEPTH	LOG	DATUM	Loc. in Sec.
Anh.				NW NE SE
TP.				
H.				
Tr.				
Dg.				
BL.				
L.				Geol.
K.C.				Contr.
B.K.C.				So. tools
Ce.				HAPPY
C.				POOL
M.				
M.				
K.				
Mz.				
Mq.				
V.				
S.				
S.				
A				
R.				
PE.				
G.				
TD.				

Lse.

No.

FIRST REPORT

NOV 30 '55

Date Comm. 11-28-55

FIRST REPORT

NOV 30 '55

County Graham Elev. 2405
 Sec. 9 Twp. 10 Rge. 23W
 Company Birmingham & Bartlett
 FarmName Johnson "E" No. 6

TOPS	DEPTH	LOG	DATUM	Loc. in Sec.
Anh.				NW NE SE
Tr.				
H.	<u>3674</u>		<u>1269</u>	
Tr.	<u>3694</u>		<u>1289</u>	
Dg.				
BL				
L.	<u>3707</u>		<u>1302</u>	Geol.
K.C.				Contr.
B.K.C.				Co. tools
Ce.				Pool
C.				Hoof
M.				
M.				
K.				
Mz.				
Me.				
V.				
S.				
S.				
A.				
R.				
Pe.				
G.				
TD.	<u>3835</u>			

Date Comm. 11-28-55 DEC 14 1955

8 5/8" @ 248 DST 3697-3722

open 25 min. rec. 10' mud 500/30"

D & A

ABANDONED

O.W.W.O.

FORM 513 SUNRAY

County Graham Elev. 2405 DF
 Sec. 9 Twp. 10 Rge. 23W
 Company Birmingham & Bartlett
 FarmName Johnson "E" No. 6

TOPS	DEPTH	LOG	DATUM
Anh.			
Tp.			
H.			
Tr.			
Dg.			
Bl.			
L. <u>KC</u>	<u>3707</u>		
K.C.			
B.K.C.			
Ce.			
C.			
M.			
M.			
K.			
Mz.			
Me.			
V.			
S.			
S.			
A.			
R.			
Pe.			
G.			
T.D. <u>OTD</u>	<u>3835</u>		

Loc. in Sec. NW NE SE
(OWWO)

Geol.

Contr.

Pool

Hoof

FIRST REPORT

MAY 29 '57

Date Comm. Was D & A
M I R T to GO

[Handwritten signature]
Harvey

Happy

County Graham Elev. 2405 DF
 Sec. 9 Twp. 10 Rge. 23W
 Company Birmingham & Bartlett
 Farm Name Johnson "E" No. 6

TOPS	DEPTH	LOG	DATUM	Loc. in Sec.
Anh.				NW NE SE
TP.				(OAK)
H.				
Tr.				
Dg.				
Bl.				
L. KC	3707			Geol.
K.C.				Contr.
B.K.C.				
Ce.				
C.				
M.				Pool
M.				Hoof
K.				
Mz.				
Me.				
V.				
S.				
S.				
A.				ABANDONED
R.				
PE.				
G.				
TD. UPD	3835			JUN 5 57

Date Comm. Was D & A

M I R T to CO JUN 5 '57 DST 3863-75

1hr run 12' Md + VSSO DIA

80 DST 3875-3914 1hr

run 30' Md BHT 275

RTP 3914

D & A