

DX 78-1


Graham

KANSAS

Section 9 Township 10 Range 23W

Well No. #1 Hoff

Company Imperial Drlg.

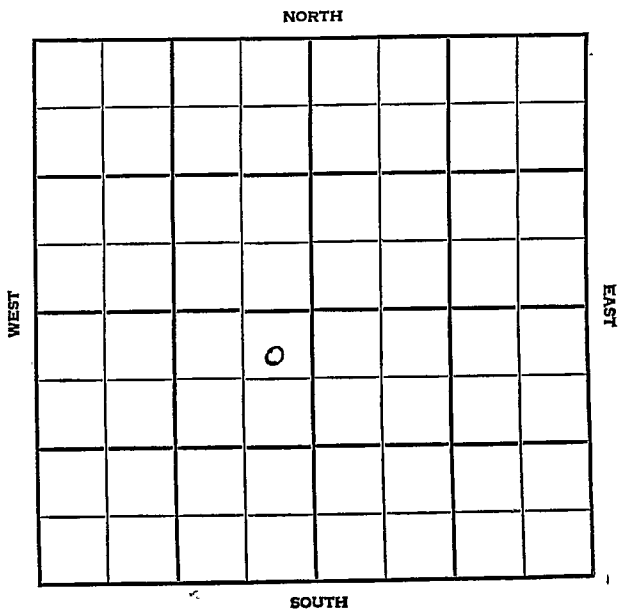

Graham		KANSAS
SEC. 9	TWP. 10	R. 23W
WELL NO. #1 Hoff		
COMPANY Imperial Drlg.		FARM
CONTRACTOR		

Wildcat.		NORTH	
330	Ft. from N. Line	<table border="1" style="width: 100%; height: 150px; border-collapse: collapse; text-align: center;"> <tr><td></td><td></td><td></td><td></td><td></td><td></td><td></td><td></td></tr> <tr><td></td><td></td><td></td><td></td><td></td><td></td><td></td><td></td></tr> <tr><td></td><td></td><td></td><td></td><td></td><td></td><td></td><td></td></tr> <tr><td></td><td></td><td></td><td></td><td></td><td></td><td></td><td></td></tr> <tr><td></td><td></td><td></td><td></td><td></td><td></td><td></td><td></td></tr> <tr><td></td><td></td><td></td><td></td><td></td><td></td><td></td><td></td></tr> <tr><td></td><td></td><td></td><td></td><td></td><td></td><td></td><td></td></tr> <tr><td></td><td></td><td></td><td></td><td></td><td></td><td></td><td></td></tr> <tr><td></td><td></td><td></td><td></td><td></td><td></td><td></td><td></td></tr> <tr><td></td><td></td><td></td><td></td><td></td><td></td><td></td><td></td></tr> </table>	
	Ft. from S. Line	
330	Ft. from E. Line	
	Ft. from W. Line	

NE NE SW
MCPC has NW $\frac{1}{4}$ of 8 N $\frac{1}{2}$ NE $\frac{1}{4}$ of 7

1954	ELEVATION	REPORT
	2430'	
11/10	Spud 11-6-54 Anhy 1475' 8" @ 217' Drlg. 2004'	
11/24	Heeb. 3669', Tor. 3690' DST 3690'-98', opn 1 hr., rec. 800' gas, 175' mco, 1215# Lans 3702' DST 3704'-11', opn 45", rec. 1700' froggy gassy oil, 1260# DST 3730-45', opn 1 hr., rec. 3000' gas, 475' mco, 1260# DST 3751-60', opn 1 hr., rec. 1100' oil, 1260# DST 3786-95', opn 1 hr., rec. 400' gcm o, 1290# DST 3800-07', opn 1 hr., rec. 280' oil, 1335# DST 3841-52', opn 1 hr., rec. 60' gas, 450' OCSW, 1200# DST 3860-71', opn 45", gas in 10", F/oil in 30", @ the rate of 43 boph DST 3880-92', opn 1 hr., gas in 25", rec. 2860' free oil, 1260# DST 3901-11', opn 1 hr., gas in 30", rec. 125' vhocm, 1200#	

(Information Brought Forward)

1954

11/24

RTD 3955'

5 $\frac{1}{2}$ " @ 3955'

WOCT

WREX

MCPC has the N/2 NE/4 of Sec 7

We recently drilled a dry hole in the SW SW NW of Sec 8 and I believe the lease has been canceled, however, I have had no notice of such cancellation. (Ltr-Scout)

12/2

CO. 24/3881-85 S/16 $\frac{1}{2}$ BOPH 4000 A

F/40-46 BOPH for 8 hr. PB 3876

23/3865-69 Hole filled in 1 hr.

F/40 BOPH for 7 hr. natural

To acidize w/5000 gal. (Ltr-Gilstrap)

12/9

A/5000 F/42 BOPH 7 hrs. DP to bottom

WOP. (Ltr-Gilstrap)

12/16

Waiting on potential.

12/23

Completed for BHB of 3000 BOPD. "

12/22

Spud 11-6-54

Oil Well

TD-3955'

8" @ 217'

Anky 1475', Heeb 3689', Tor 3690'

DST 3690'-98' opn 1 hr, rec 800' gas, 175' mco, 1215# Lans 3702'

DST 3704'-11' opn 45 min rec 1700' frothy gassy oil 1260#

DST 3730'-45' opn 1 hr, rec 3000' gas 475' mco, 1260#

DST 3751'-60' opn 1 hr, rec 1100' oil 1260#

DST 3751'-60' opn 1 hr, rec 1100' oil 1260#

DST 3786'-95' opn 1 hr, rec 400' gcmo 1290#

DST 3841'-52' opn 1 hr, rec 60' gas, 450' socsw, 1200#

DST 3800'-07' opn 1 hr, rec 280' oil 1335#

DST 3841'-52' opn 1 hr, rec 60' gas 450' ocs. 1200#

DST 3860'-71' opn 45 min, gas in 10 min F/ oil in 30 min, 43 boph

1954

#1 Hoff


Information brought forward.

12/22 DST 3880'-92' opn 1 hr, rec 2860' free
oil, 1260#
DST 3901'-11' opn 1 hr, gas in 30 min
rec 125' whocm 1200#
TD 3955'
5" @ 3955'
CO 24/ 3881'-85' S/ $16\frac{1}{2}$ boph 4000 A
F/ 40 to 46 boph 8 hr.
PB 3876'
23/ 3865'-69' hole filled in 1 hr.
F/ 40 boph 7 hr. 5000 A F/ 42 boph
7 hr.
Comp 3000 bopd.

COMPLETED

FABEN GILSTADT

County Graham State Kansas
 Sec. 9 (Blk.) 10 (Sur.) 23W Map No.
 Operator Imperial Drlg.
 Well No. 1 Farm Hoof
 Elev. 2430 Location NE NE SW

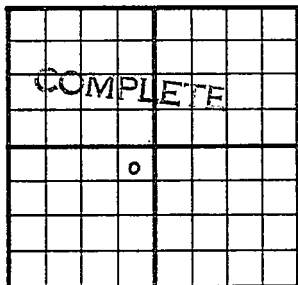

330 Ft. From N Line SW
330 Ft. From E Line Quarter
 Ist. Report
 Completion DEC 22 1954
 Remarks Hoof Pool
 Spudding Date 11-6-54

Drlg. Data Oil well TD 3955
8" @ 217 Anhy 1475 Heeb. 3669
Tor. 3690 DST 3690-98 open 1 hr.
Rec. 800' gas 175' mco 1215#
Lans. 3702 DST 3704-11 open 45 min.
Rec. 1700' frothy gassy oil 1260#
DST 3730-45 open 1 hr. Rec. 3000' gas
475' mco 1260# DST 3751-60 open 1 hr.
Rec. 1100' oil 1260# DST 3786-95
open 1 hr. Rec. 400' gemo. 1290#
DST 3841-52 open 1 hr. Rec. 60' gas
450' socsw 1200# DST 3800-07
open 1 hr. Rec. 280' oil 1335#
DST 3841-52 open 1 hr. Rec. 60' gas
450' ocs w 1200# DST 3860-71

FABEN GILSTRAP

Drlg. Data

open 45 min. gas in 10 min. F/ oil in
30 min. 43 boph DST 3880-92 open 1 hr.
Rec. 2860! free oil 1260# DST 3901-11
open 1 hr. gas in 30 min. Rec. 125' -who
cm 1260# TD 3955 5" @ 3955
CO 24/ 3881-85 S/ 36 1/2 boph 4000 A
F/ 40 to 46 boph 8 hr PB 3876
23/ 3865-69 hole filled in 1 hr.
F/ 40 boph 7 hr. 5000 A F/ 42 boph 7 hr
Comp. 3000 bopd