

Graham


KANSAS

SECTION 9 TOWNSHIP 10 RANGE 23 W

WELL NO. #5 Hoof "A"

COMPANY Imperial Drlg.

NORTH

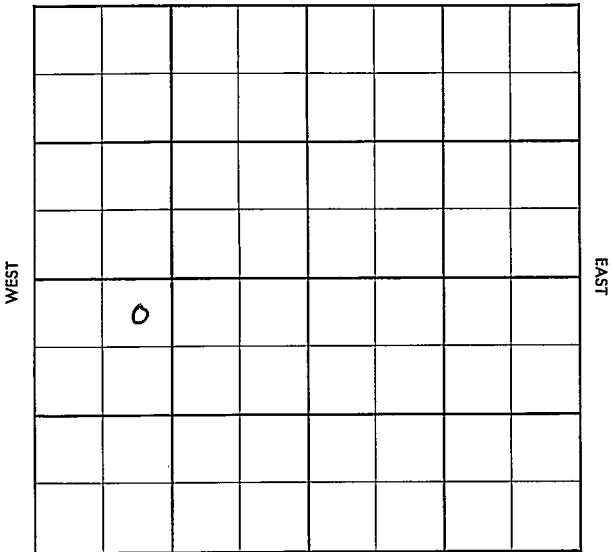

SOUTH

Graham

KANSAS

SEC.	TWP.	R.
9	10	23W

WELL NO.

#5 Hoof "A"

FARM

COMPANY

Imperial Drlg.

CONTRACTOR

Co. Tools

Diebolt


Ft. from N. Line

Ft. from S. Line

Ft. from E. Line

Ft. from W. Line

NE NW SW

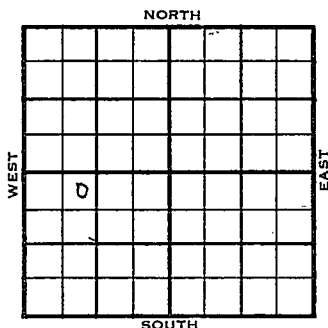

1955

ELEVATION

2425

REPORT

12-21

RUR

1956

2-8

Comm. 12-20-55

8 5/8" @ 222'

DST 3785-94 op 1 hr. rec. 60' HOCM / 420' clean oil, BHP 1135/20

DST 3886-39, op 1 hr. / 120' GIP, rec 5' oil / 360' GCSW, BHP 440

5 1/2" @ 3905

CO 30/ 3873-77

S/ 18 BOPH nat

S/ 35 ~~###~~ BOPH, 900 O.B.

POP

Waiting on Potential

BH Bomb

P/ 2151 BOPD

Anh. 1985

L. 3714

TD 3905

COMPLETED

County Graham Elev. _____
 Sec. 9 Twp. 10 Rge. 23W
 Company Imperial Drlg.
 Farm Name Hoof "A" No. 5

TOPS	DEPTH	LOG	DATUM	Loc. in Sec.
Ann.				NE NW SW
Tr.				
H.				
Tr.				
Dg.				
Bl.				
L.				
K.C.				Geol.
B.K.C.				Contr.
Ce.				Co. tools
C.				Pool
M.				Diebolt
M.				
K.				
Mz.				
Mo.				
V.				
S.				
S.				
A.				
R.				
Pe.				
G.				
T.D.				

FIRST REPORT

DEC 21 '55

Date Comm.

RUR

Co.

Lse

No.

Sec.

T.

R.

1 55 W O P O T JAN 18 '56 JAN 25 '56 V FEB 1 '56
B 56 B H B U R D P 2151 B o p d

R. G.

FEB 22 1956

22 FEB 1956