
DX 78-1 Graham

KANSAS

Section 9 Township 10 Range 23W

Well No. #6 Hoof "A"

Company Imperial Oil

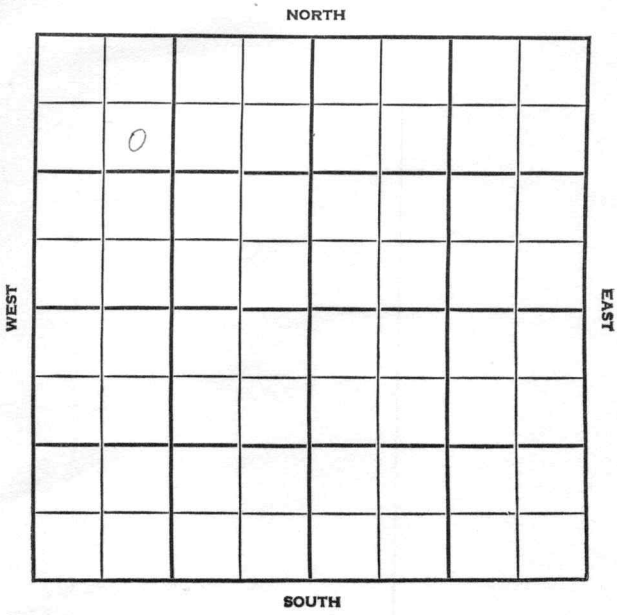

Graham KANSAS

SEC.	TWP.	R.
9	10	23W

WELL NO.

#6 Hoof "A" FARM

COMPANY

Imperial Oil

CONTRACTOR

Co. Tools

Hoof


_____ FT. FROM N. LINE

_____ FT. FROM S. LINE

_____ FT. FROM E. LINE

_____ FT. FROM W. LINE

SE NW NW

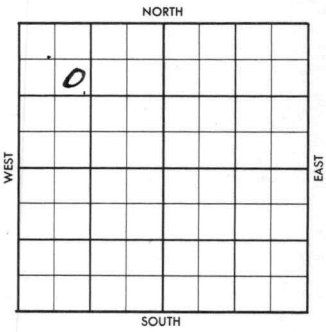

1956	ELEVATION 2421' REPORT

7-18 Location
8-15 Comm. 8-1-56
8 5/8" @ 230
DST 3716-38 op 30 min. rec. 6' mud,
BHP 1070#.
DST 3808-18 op 30 min. rec. 3' mud,
BHP 30#.
DST 3894-3913 op 30 min. rec. 7' mud,
BHP 0#.
DST 3910-30 op 30 min. rec. 10' mud,
BHP 30#.
D & A
Anh. 1997'; H. 3709'; L. 3744';
TD 3968'

ABANDONED

FORM 513 SUNRAY

County Graham Elev.

Sec. 9 Twp. 10 Rge. 23W

Company Imperial Oil

Farm Name Hoof "A" No. 6

TOPS	DEPTH	LOG	DATUM
Anh.			
Tp.			
H.			
Tr.			
Dg.			
B.L.			
L.			
K.C.			
B.K.C.			
Ce.			
C.			
M.			
M.			
K.			
Mz.			
Mg.			
V.			
S.			
S.			
A			
R.			
P€.			
G.			
T.D.			

Loc. in Sec. SE NW NW

Geol.

Contr. Co. tools

Pool HAPPY Hoof



Date Comm. JUL 18 '56

Location

Co. Lse. No. Sec. T. R.

FORM 513 SUNRAY


Sec. 9 Twp. 10 Rge. 23W

Company Imperial Oil

Farm Name Hoss "A" No. 6

TOPS	DEPTH	LOG	DATUM
Anh.	1997		
Tp.			
H.	3709		
Tr.			
Dg.			
Bl.			
L.	3744		
K.C.			
B.K.C.			
Ce.			
C.			
M.			
M.			
K.			
Mz.			
Mo.			
V.			
S.			
S.			
A			
R.			
P€.			
G.			
T.D.	3968		

Loc. in Sec. SE NE NW

Geol.

Contr. Co. Tools

Pool HAPPY Hoss

ABANDONED

AUG 15 '56

Date Comm.

Location JUL 25 '56 AUG 1 '56 AUG 8 '56

8-1-56 8 5/8 230 D 3494

AUG 15 '56 DST 3716-38 30" rec 6' Md BHP 1070 DST 3808-18 30" rec 3' Md BHP 30 DST 3894-3913 30" rec 7' Md BHP 0 DST 3910-30 30" rec 10' Md BHP 30

D&A

Co. Sec. T. R. No.