


Section 9 Township 10 Range 23 W
Well No. # 1 Hoof "B"
Company Imperial Drlg.

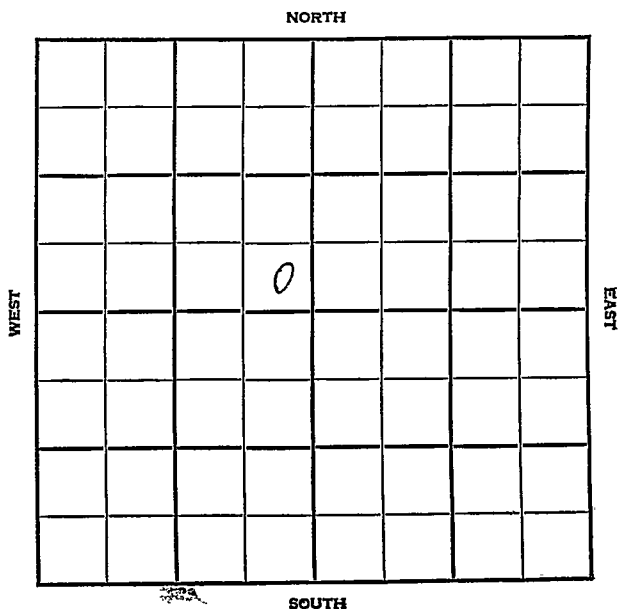

Graham

KANSAS

SEC.	TWP.	R.
9	10	23 W
WELL NO.		
# 1 Hoof "B"		
COMPANY		FARM
Imperial Drlg.		
CONTRACTOR		


_____ Ft. from N. Line

330 _____ Ft. from S. Line

330 _____ Ft. from E. Line

_____ Ft. from W. Line

SE SE NW

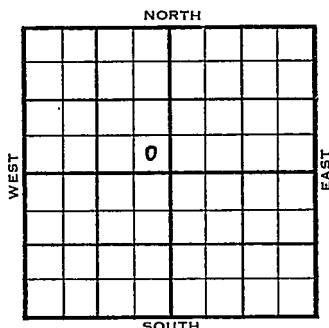

1954	ELEVATION 2436'	REPORT
12/1	Location	
1955 1/5	Spud 12-2-54 Oil Well TD 3967' 8" @ 215' Anhy 1990' Heeb 3688' Lans 3721' DST 3722'-30' opn 1 hr, rec 16' s.w. 1200# DST 3750'-63' opn 1 hr, rec 2200' s.w. 1290# DST 3769'-79' opn 1 hr, rec 40' o & gcm 60' s.w. 890# DST 3880'-91' opn 50 min, rec 3560' clean gassy oil, 1220# DST 3897'-3912' opn 1 hr, rec 10' socm 0# DST 3912'-24' opn 45 min, rec 5' Mud 0# TD 3967' 5" @ 3967' CO 24/ 3881'-85' S/ 20 boph 3000 A F/ 11 boph 2 hr. Comp 3000 bopd.	
		COMPLETED

FABEN GILSTRAP

County Graham State KansasSec. 9 (Blk.) 10 (Sur.) 23W Map No.Operator Imperial Drlg.Well No. 1 Farm Hoof "B"Elev. 2436 Location SE SE NW

330 Ft. From S Line NW330 Ft. From E Line Quarter

1st. Report

Completion JAN 5 1955

Remarks

Spudding Date 12-2-54Drlg. Data Oil well TD 39678" @ 215 Anhy 1990 Heeb. 3688Lans. 3721 DST 3722-30 open 1 hr.Rec. 16' sw 1200# DST 3750-63open 1 hr. Rec. 2200' sw 1290#DST 3769-79 open 1 hr. Rec. 40' o & gcm60' sw 890# DST 3880-91 open 50 min.Rec. 3560' clean gassy oil 1220#DST 3897-3912 open 1 hr. Rec. 10' socm0# DST 3912-24 open 45 min. Rec.5' mud 0# TD 3967 5" @ 3967CO 24/ 3881-85 S/ 20 boph 3000 AF/ 11 boph 2 hr. Comp. 3000 bopd

FABEN GILSTRAP