


DX 78-1 Graham

KANSAS

Section 9 Township 10 Range 23W

Well No. #6 Hoof "B"

Company Imperial Pet.

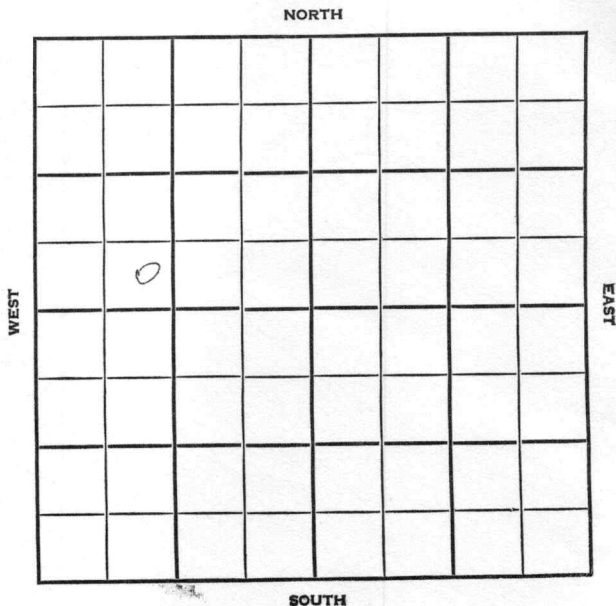

Graham

KANSAS

SEC.

TWP.

R.

9

10

23W

WELL NO.

#6 Hoof "B"

FARM

COMPANY

Imperial Petroleum

CONTRACTOR

Harms-Burt

Hoof


____ FT. FROM N. LINE

____ FT. FROM S. LINE

____ FT. FROM E. LINE

____ FT. FROM W. LINE

SE SW NW

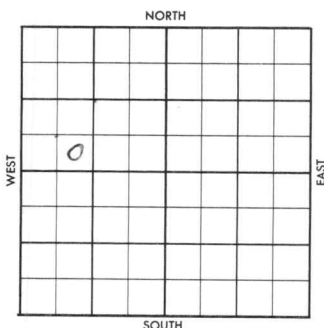

1956

ELEVATION

2425'

REPORT

6-6

Location

7-18

Comm. 6-7-56

8" @ 202 w/150

DST 3693-3716 op 30 min, rec. 4' mud,
BHP 60/20"DST 3787-3801 op 30 min, rec. 5' mud,
BHP 60/20".DST 3870-88 op 1 hr, 2800' GIP, rec.
500' mdy oil, BHP330#.

5 1/2" @ 3942 w/100

CO 30/3880-85

S/ 6 3/4 BOPH, 4 hrs.

S/ 13 BOPH, 10 hrs.

P/ 223 BOPD, no/wtr.

Grav. 40.

Anh. 1985'; H. 3688'; Tr. 3706';

L. 3720'

TD 3942'

COMPLETED

County

Graham

Elev.

Sec.

9

Twp.

10

Rge.

23W

Company

Imperial Pet.

Farm Name

Hoof "B"

No.

6

TOPS

DEPTH

LOG

DATUM

Loc. in Sec.

Anh.

Tp.

H.

Tr.

Dg.

Bl.

L.

K.C.

B.K.C.

Ce.

C.

M.

M.

K.

Mz.

Mq.

V.

S.

S.

A.

R.

Pe.

G.

T.D.

SE SW NW

Geol.

Contr.

Hams-Burt

Pool HAPPY

Hoof

FIRST REPORT

JUN 6 '58

Date Comm.

Location

JUN 1 1958

R.G.

Co.

County Graham Elev. 2425
 Sec. 9 Twp. 10 Rge. 23W
 Company Imperial Pet.
 Farm Name Hoof. "B" No. 6

TOPS	DEPTH	LOG	DATUM	Loc. in Sec.
Anh.	<u>1985</u>			SE SW NW
TP.				
H.	<u>3688</u>			
Tr.	<u>3706</u>			
Dg.				
BL.				
L.	<u>3720</u>			Geol.
K.C.				Contr.
B.K.C.				<u>Dams-Burt</u>
Ce.				Pool <u>HAPPY</u>
C.				Hoof
M.				
M.				
K.				
Mz.				
Me.				
V.				
S.				COMPLETE
S.				
A.				
R.				
PE.				JUL 18 1956
G.				
T.D.	<u>3942</u>			

Use.

No.

Sec.

T.

R.

Date Comm.

Location JUN 13 '56 S-1 B-7-568" 202/150 Q2885 JUN 20 '56

DST 3693-3716 30" rec 4'
Md BHP 60/20 DST 3787-3801
30" rec 5' Md BHP 60/20
DST 3870-88 1 hr 2800' G1R
rec 500' Mdy oil BHP 330 5 1/2
@ 3942/100 JUN 27 '56 CO 30/3880-85
\$ 6 3/4 Boph 4 hrs 1/3 \$ 13 Boph

9-10-23W SE SW NW

10 hrs POY JUL 3 '56 JUL 11 '56 JUL 18 '56

Ph P. 223 Bopd no/wh

graw 40°

9-10-23 or over-nu