Graham


DX 78-1

KANSAS

Section 9 Township 10 Range 23W

Well No. #1 Johnson "E"

Company Birmingham & Bartlett

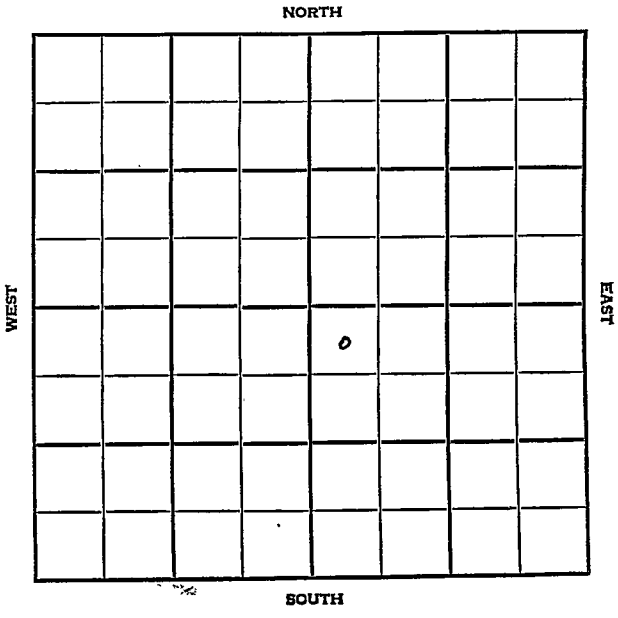

Graham **KANSAS**

SEC.	TWP.	R.
9	10	23W

WELL NO.

#1 Johnson "E" FARM

COMPANY

Birmingham & Bartlett

CONTRACTOR

Co. Tools.


330 Ft. from N. Line

_____ Ft. from S. Line

_____ Ft. from E. Line

330 Ft. from W. Line

NW NW SE

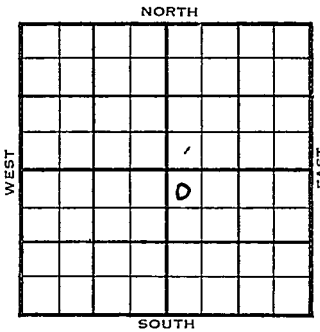

1954	ELEVATION 2404' REPORT
11/23	Spud 11-19-54 8" @ 242' Drlg. 2890'
12/15	Spud 11-19-54 Oil Well TD 3925' 8" @ 242' Anhy 1955', Heeb 3645', Tor. 3666' Lans 3678' DST 3679'-86' opn 45 min, rec 1320' oil, 1275# DST 3743'-56' opn 45 min, rec 1100' gas 90' wtho & gcm, 60' free oil 1250# DST 3790'-3803' opn 20 min, rec 10' Mud, 0# DST 3836'-46' opn 35 min, F/ oil in 33 min, 1230# DST 3853'-69' opn ½ hr, rec 3200' gas, 360' free oil, 1180# DST 3891'-3905' opn 45 min, rec 25' Mud 100# TD 3925' 5" @ 3925' CO 12/ 3836-44 FU oil F/ 17 bo 1 hr. 3000 A F/ 33 boph 3 hr. Comp 3000 bopd. COMPLETED

DX-78

FORM 275 FOR SALE BY KANSAS BLUE PRINT CO.


County Graham State Kansas

Sec. 9 (Blk. Twp.) 10 (Sur. Rge.) 23W Map No.

Operator Birmingham & Bartlett

Well No. 1 Farm Johnson "E"

Elev. Location NW NW SE

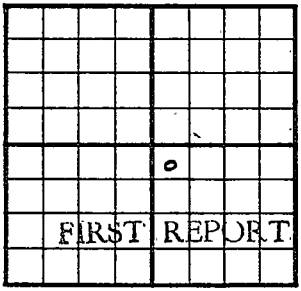

330 Ft. From N Line SE

330 Ft. From W Line Quarter

1st. Report NOV 23 1954

Completion

Remarks Co. tools

Spudding Date 11-19-54

Drlg. Data

8" @ 242 drlg. 2890

FABEN GILSTRA

FORM 275 FOR SALE BY KANSAS BLUE PRINT CO.


County Graham State Kansas

Sec. 9 (Blk. Twp.) 10 (Sur. Rge.) 23W Map No.

Operator Birmingham & Bartlett

Well No. 1 Farm Johnson "E"

Elev. 2404 Location NW NW SE

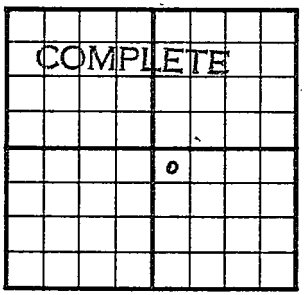

330 Ft. From N Line SE

330 Ft. From W Line Quarter

1st. Report

Completion DEC 15 1954

Remarks

Co. tools

Spudding Date 11-19-54

Drlg. Data Oil well TD 3925

8" @ 242 Anhy 1955 Heeb. 3645

Tor. 3666 Lans. 3678 DST 3679-86

open 45 min. Rec. 1320' oil 1275#

DST 3743-56 open 45 min. Rec. 1100' gas

90' vho & gcm 60' free oil 1250#

DST 3790-3803 open 20 min. Rec. 10' mud

0# DST 3836-46 open 35 min. F/ oil in

33 min. 1230# DST 3853-69 open ½ hr.

Rec. 3200' gas 360' free oil 1180#

DST 3891-3905 open 45 min. Rec. 25' mud

100# TD 3925 5" @ 3925 CO

12/ 3836-44 FU oil F/ 17 bo 1 hr.

3000 A F/ 33 boph 3 hr.

Comp. 3000 bopd

FABEN OILSTRAP