


Section 1 Township 11 Range 16
16W

Well No. #1 Bowlby "C"

Company Cities Service

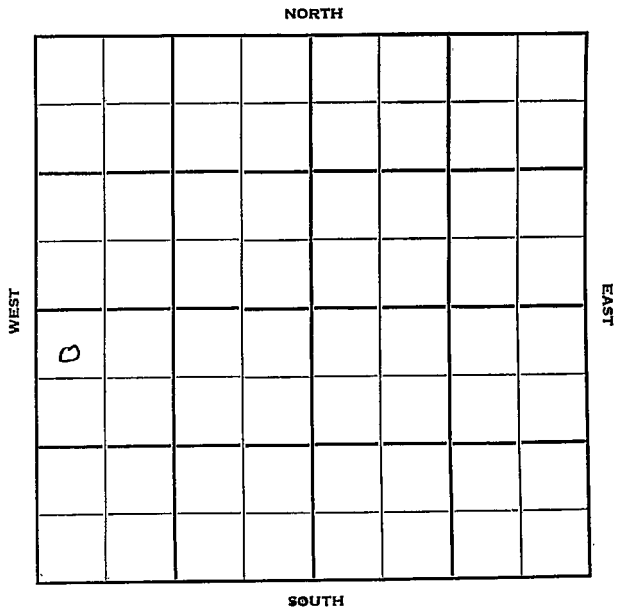

Sec. 1 Twp. 11 R. 16W

Well No. #1 Bowlby "C" Farm

Cities Service Company

Holm Drlg. Contractor


_____ Ft. from N. Line

2310 Ft. from S. Line


_____ Ft. from E. Line

330 Ft. from W. Line

NW NW SW

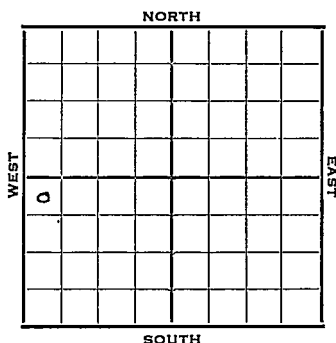


1952	Elevy 2020' REPORT
5/14	Location
5/21	"
5/28	8" @ 277 Drlg. 2838'
6/11	Spud 5-22-52 D & A TD 3510' 8" @ 277 Lans. 3217' 3 DST failed DST 3268-80 open 1 hr. rec 20' SOGM DST 3313-24 open 1 hr. rec 34' mud & water. TD 3510' Top. 2912' Heeb 3172' Dodge 3193' D & A
	ABANDONED

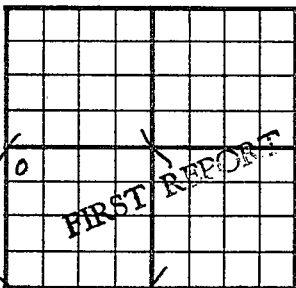County Ellis State KansasSec. 1 (Blk. 11 (Sur. 16W Map No. 11 (Twp. 16W (Rge. 11Operator Cities ServiceWell No. 1 Farm Bowlby "C"Elev. Location NW NW SW2310 Ft. From S Line SW330 Ft. From W Line Quarter1st. Report MAY 14 1952Completion Remarks Holm Drlg. - Contr.Spudding Date Drlg. Data Location

J. G. McGENEE

County Ellis State Kansas
 Sec. 1 (Blk.) 11 (Sur.) 16W Map No.
 Operator Cities Service
 Well No. 1 Farm Bowlby "C"
 Elev. 2020 Location NW NW SW

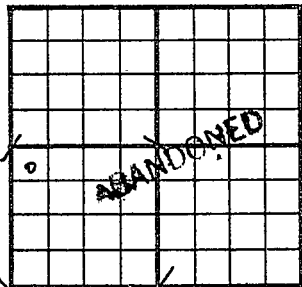

2310 Ft. From S Line SW
330 Ft. From W Line Quarter

1st. Report

Completion JUN 11 1952

Remarks

Holm Drlg. - Contr.

Spudding Date 5-22-52

Drlg. Data D & A TD 3510

8" @ 277 Lans. 3217 3 DST failed

DST 3268-80 open 1 hr. Rec. 20' socm

DST 3313-24 open 1 hr. Rec. 34' mud

& water TD 3510 Top. 2912

Heeb. 3172 Dodge 3193

D & A

J. G. McGEHEE