


Section 1 Township 11 Range 18-W

Well Number 1 - Burnett

Company Wakefield et al

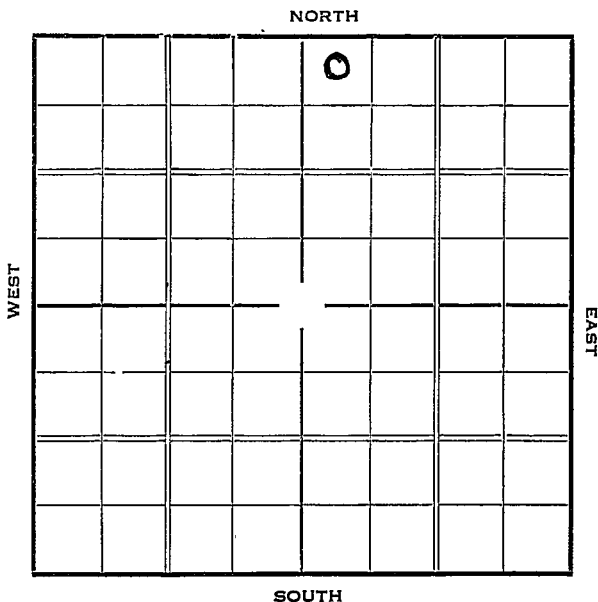

Sec. 1 Twp. 11 R. 18-W


Well No. #1 Burnett Farm
Wakefield et al Company

330 Ft. from N. Line

_____ Ft. from S. Line

_____ Ft. from E. Line

330 Ft. from W. Line

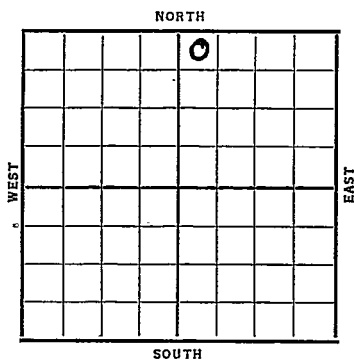

Special

Date	Elev. ²⁰³³ 2032 REPORT
1937	
5/19	MOV. in cable tools.
5/28	" " " "
6/4	Rig'n up tools.
6/11	15" @ 129'. Drlg. 240'.
6/19	12" @ 679'. Drlg. 1050'.
6/25	10" @ 1076'. Anhy 1310'. Drlg. 1380'.
7/2	10" @ 1310'. Drlg. 2185'.
7/9	8" @ 2503'. Drlg. 2555'.
7/16	T.D. 2700'. Fsg.. U. R.
7/23	" " " "
7/30	Cleaned up fishing job & SD for pipe.
8/6	T.D. 2715'. 8" @ 2668'. C.O.
8/13	T.D. 2775'. Rng. 6".
8/20	6" @ 2788'. T.D. 2835'. C.O.
8/28	6" @ 2963'. Topeka 2960 . ²⁹⁸⁵ Drlg. 3020'.
9/3	Topeka 2985' (Corrected) 6" @ 3024'. Drlg. 3065'.

OVER

1937

- 9/10 Sm. S.O. 3155-60' H.F.W.
3160-65'. T.D. 3199' Fsg.
- 9/17 6" @ 3207'. S.O. 3227-38'.
K.C. 3245'. S.O. 3275-82'.
H.F.W. 3290-92' T.D. U.R. 6".
- 9/24 S.O. 3330-3337'. 3343' H.F.W.
T.D. 3359'. U.R. 5".
- 9/29--Siliceous 3570 T.D. 3572
2600 feet oil 1 hour (Telegram)
- 10/2 6" @ 3336'. Cong. 3498'.
Simp. Dolomite 3552' Sm. S.O.
5" @ 3553'. Sil. 3570'.
T.D. 3572'. 2600' oil in 1 hr.
Total fill-Up 3000'.
- 10/8 T.D. 3574'. 5" @ 3569'.
3000' oil. Grav. 31.6/79
- 10/16--Top Siliceous 3570 T.D. 3574
1st 4 hrs. pump 315 bbls.
2nd 4 " " 320 "
24 hour potential 1890 bbls.
Gravity 31.6 (Tel)
- 10/20 5" @ 3569'.
Sil. 3570'.
T.D. 3574'.
P. 315/4 & 320/4
Potential 1890 bbls. Nat.
Gravity 32.5/81.

COMPLETED

Ellis

KANSAS

Map No. _____ Sec. 1 Twp. 11 R. 18W

Well No. 1 Burnett

Wakefield etal Company

Contractor

COMPLETED

SECTION PLAT

NW NE

330 Ft. from N. Line

_____ Ft. from S. Line

_____ Ft. from E. Line

330 Ft. from W. Line

		0	

Location _____

Rig up _____

Drilling and Remarks:

P. 315/4 & 320/4

*POT - 1890
NAT.*

Gravity 32.5/81

RECORD

Cased 5 in., 3569 ft.

Sand 511 3570

Gas _____

Oil _____

Total Depth 3574

PRODUCTION

1st 24 hrs. Nat. _____

1st 24 hrs. after shot _____

Gas _____ Cu. Ft.

Dry Hole _____

Abandoned _____

Date

NOV 20 1937 19 H. D. Hatfield Scout

[Handwritten scribbles and lines]

[Handwritten initials]
[Handwritten initials]

Returned

Ellis KANSAS

Map No. 71 Sec. 1 Twp. 11 R. 18^w

Well No. 1 - Burnett

Wakefield et al Company
 Contractor

FIRST REPORT

330 Ft. from N. Line
 _____ Ft. from S. Line
 _____ Ft. from E. Line
330 Ft. from W. Line

Special

SECTION PLAT

		0	

Location _____

Rig up _____

Drilling and Remarks:

*mov. in
 cable tools*

RECORD

Cased _____ in., _____ ft.
 Sand _____
 Gas _____
 Oil _____
 Total Depth _____

PRODUCTION

1st 24 hrs. Nat. _____
 1st 24 hrs. after shot _____
 Gas _____ Cu. Ft.
 Dry Hole _____
 Abandoned _____

Date

MAY 19 1937

H. D. Hatfield

19

Scout

RAY

Returned	_____
Cards	_____
Tracing	_____
France Map	_____
Scarborough Map	_____
Moody Map	_____
Scarborough Plat Book	_____
Moody Plat Book	_____