


Section 1 Township 11 Range 18-W

Well No. #1 Barbier "A"

Company Hay Pet.

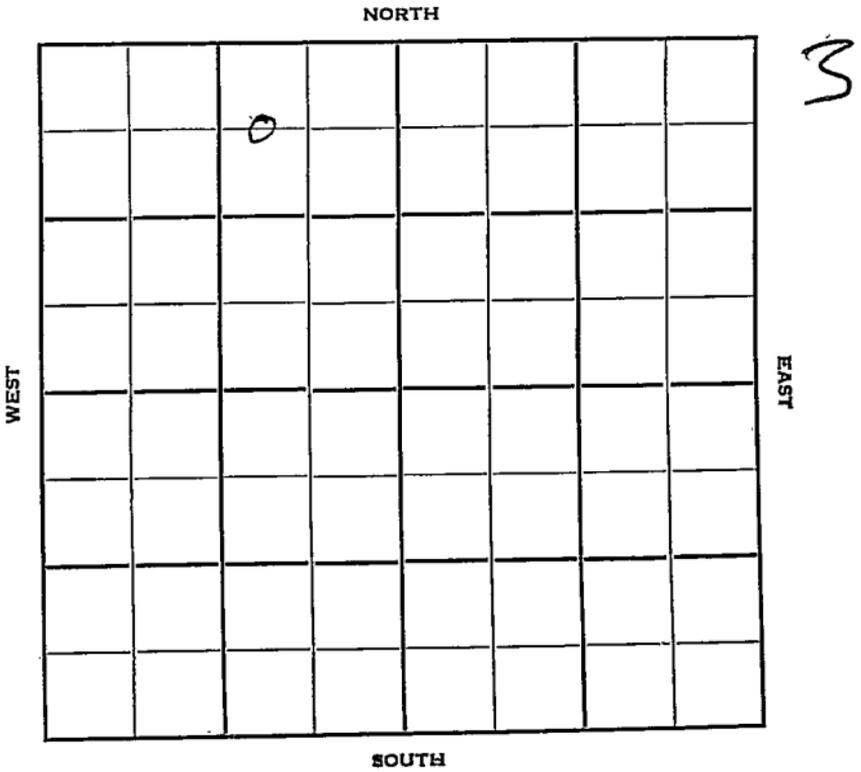

Ellis

KANSAS

Sec. 1 Twp. 11 R. 18W

Well No. #4 Barbier "A" Farm

Bay Petroleum

Company

Contractor

Burnett


660' Ft. from N. Line

_____ Ft. from S. Line

990' Ft. from E. Line

_____ Ft. from W. Line

C W L NEW

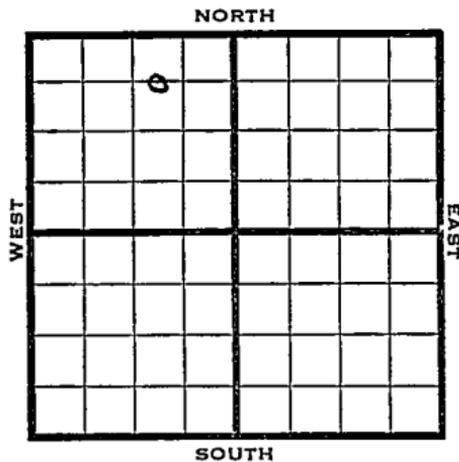

1950	Elev 1915 REPORT
8/9	Spud 8-6-50. Anhy 1195' 8" @ 1210' Drlg. 2215'
9/20	Anhy 1195 8" @ 1210 Heeb 3094 Dodge 3115 Lans 3134 Cong 3382 Arb 3452-54 5" @ 3453 ED 3454 FU 500' oil 1 hr S/7 boph for 8 hr Comp 288 bopd Completed
	COMPLETED

County **Ellis** State **Kansas**

Sec. **1** (Blk. Twp.) **11** (Sur. Rge.) **18W** Map No.

Operator **Bay Petroleum**

Well No. **4** Farm **Barbier "A"**

Elev. Location **C W L NE NW**

	0				

560 Ft. From **N** Line **NW**

990 Ft. From **E** Line **Quarter**

Ist. Report **AUG 9 1950**

Completion

Remarks

FIRST REPORT

Spudding Date **8-6-50**

Drig. Data

Anhy 1195 8" @ 1210 drig. 2215

J. E. TYRA

