

Section 1 Township 11 Range 18W

Well No. #5 Barbier "A"

Company Bay Petroleum

NORTH

WEST	0						

EAST

SOUTH

4

KANSAS

Ellis

Sec. 1 Twp. 11 R. 18W

Well No. #5 Barbier "A" ☒ Farm

Bay Petroleum Company

Pickrell Drlg. - Contr. Contractor

Burnett Pool


330' Ft. from N. Line

 Ft. from S. Line

 Ft. from E. Line

330' Ft. from W. Line

NW NW NW

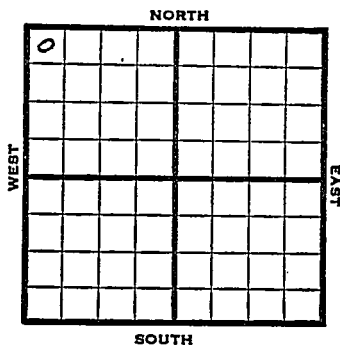

1951

Elev. 1990' REPORT

1/24

RIR

3/28

Spud 1-19-51

Oil well TD 3540'

8" @ 190' Lans. 3212

DST 3397-3436 open 40 min. Rec. 10' mud & SS0,

Cong. 3458

DST 3458-71 open 45 min. Rec. 7' mud

Arb. 3536-38', 5" @ 3537'

TD 3540' S/ 2 1/2 BOPH

Comp. 54 bopd

COMPLETED

County **Ellis** State **Kansas**

Sec. **1** (Blk. **11** (Sur. **18W** Map No.

Operator **Bay Petroleum**

Well No. **5** Farm **Barbier "A"**

Elev. Location **NW NW NW**

0							

330 Ft. From **N** Line **NW**

330 Ft. From **W** Line **Quarter**

1st. Report **JAN 24 1951**

Completion

Remarks

Pickrell Drlg. - Contr.

Spudding Date

Drlg. Data **Burnett Pool**

R U R

County Ellis State KansasSec. 1 (Blk.
Twp.) 11 (Sur.
Rge.) 18W Map No.Operator Bay PetroleumWell No. 5 Farm Barbier "A"Elev. 1990 Location NW NW NW

0					

330 Ft. From N Line NW330 Ft. From W Line Quarter

1st. Report

Completion MAR 28 1951Remarks Burnett PoolPickrell Drlg. - Contr.Spudding Date 1-19-51Drlg. Data Oil well TD 35408" @ 190 Lans. 3212 DST 3397-3436open 40 min. Rec. 10' mud & SS0Cong. 3458 DST 3458-71 open 45 min.Rec. 7' mud Arb. 3536-38 5" @ 3537TD 3540 S/ 2 $\frac{1}{2}$ boph Comp. 54 bopd

J. E. TYRA