


Section 1 Township 11 Range 18W

Well No. #5 Burnett

Company Earl Wakefield

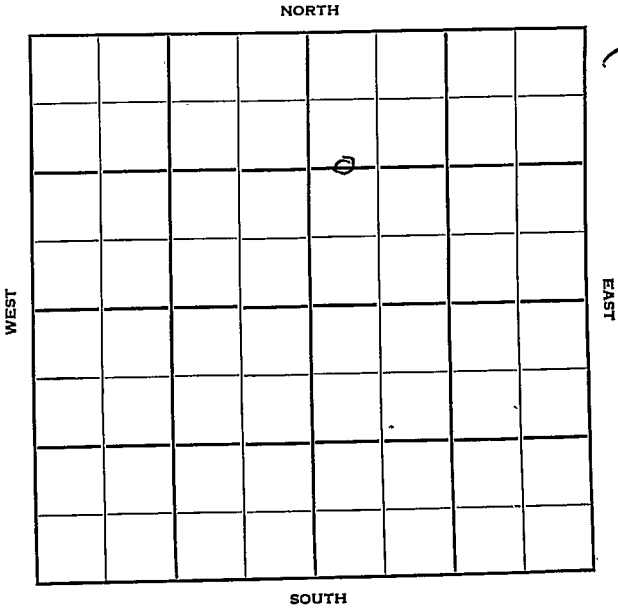

Sec. 1 Twp. 11 R. 18W

Well No. #5 Burnett Farm

Earl Wakefield Company

Contractor


1320' Ft. from N. Line

..... Ft. from S. Line

..... Ft. from E. Line

330' Ft. from W. Line

C W/2 W/2 NE

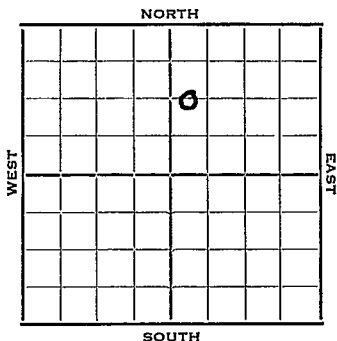

1952 Elev. 1959' REPORT

2/13	2-11-52 8" @ WOC
2/20	8" @ 72' Heeb 3141' Lans. 3182' Drlg. 3261'
3/5	DO to 3504' Est 2500' oil fill up 10 hrs. POP
3/12	POP
3/19	"
3/25	"
4/1	NR
4/9	"
4/23	"
4/30	Spud 2-11-52 Oil well TD 3504' 8" @ 72 Heeb 3141' Lans. 3182' Arb. 3502' TD 3504' 5" @ 3503' FU 2500' oil 10 hr. Comp. 87 BOPD 66% water.

COMPLETED

County Ellis State Kansas

Sec. 1 (Blk. 11 (Sur. 18W (Twp.) 11 (Rge.) 18W Map No.

Operator Earl Wakefield

Well No. 5 Farm Burnett

Elev. 1959 Location C W $\frac{1}{2}$ W $\frac{1}{2}$ NE

1320Ft. From N Line NE

330Ft. From W Line Quarter

1st. Report

Completion APR 30 1952

Remarks

Spudding Date 2-11-52

Drig. Data Oil well TD 3504

8" @ 72 Heeb. 3141 Lans. 3182

Arb. 3502 TD 3504 5" @ 3503

FU 2500' oil 10 hr.

Comp. 87 bopd 66% water