

KANSAS

Form 51-5M-7-39-Palace


Ellis

Section 1 Township 11 Range 18-W

Well No. #2 Burnett "A"

Company Wakefield

NORTH Peavey Pool

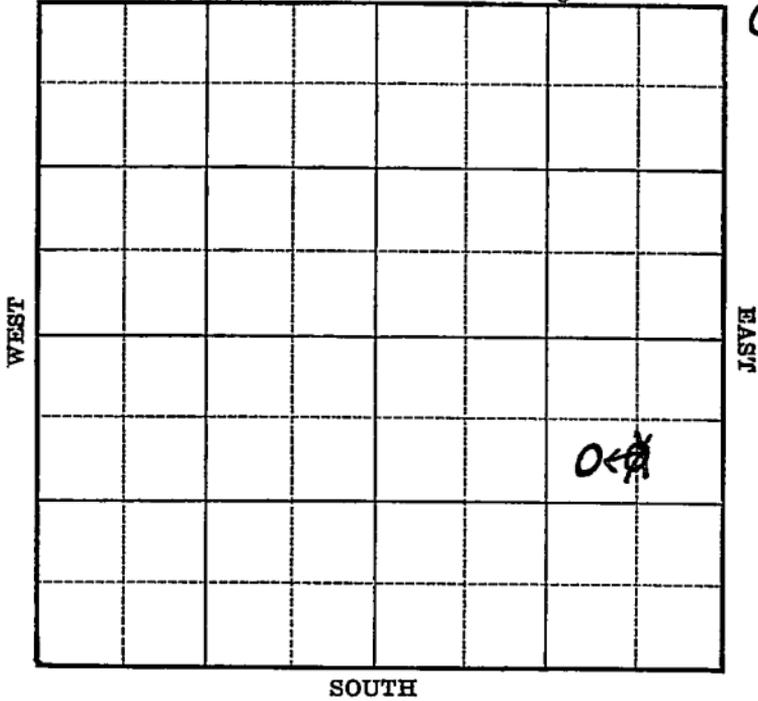

Sec. 1 Twp. 11 R. 18-W

Well No. #2 Burnett "A" Farm

Wakefield Company

(Peavey)


990 Ft. from N. Line

_____ Ft. from S. Line

990
~~660~~ Ft. from E. Line

_____ Ft. from W. Line

Elev. 2036

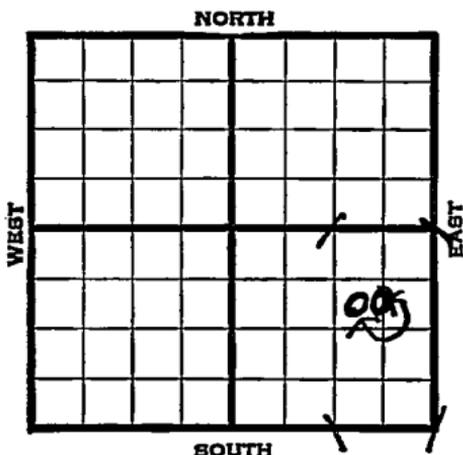

1939

REPORT

11/22

13" - 80'

Anhy 1305'

8" - 1312' WOC.

11/29

Drlg. 2579'

12/7

Drlg. 3465'

12/14

Cong. 3515' Arb. 3567'

5" - 3569' T.D. 3571' RUST.

12/20

Arb. 3567'

5" - 3569'

T.D. 3575'

1000 acid.

Depthograph potential 10,737 bbl

Maximum 3000 bbls.

COMPLETED

Map No. 71 Sec. 1 Twp. 11 R. 18WWell No. 2 Burnett "A"Wakefield

Company

Contractor

FIRST REPORT

C S L NE SE

990 Ft. from N. Line

_____ Ft. from S. Line

660 Ft. from E. Line

_____ Ft. from W. Line

PEAVEY POOL

SECTION PLAT

Location _____

RECORD

Cased _____ in., _____ ft.

Sand _____

Gas _____

Oil _____

Total Depth _____

PRODUCTION

1st 24 hrs. Nat. _____

1st 24 hrs. after shot _____

Gas _____ Cu. Ft.

Dry Hole _____

Abandoned _____

Rig up _____

Drilling and Remarks:

13" - 80Anhy. 13058" - 1312

WOC

Date

NOV 22 1939 19

S. J. LEWIS Scout

Map No. 71 Sec. 1 Twp. 11 R. 18W

Well No. 2 Burnett "A"

Wakefield

Company

CORRECTION

Contractor

SW NE SE

SECTION PLAT

990 Ft. from N. Line

			o

_____ Ft. from S. Line

990 Ft. from E. Line

_____ Ft. from W. Line

PEAVEY POOL

Location _____

RECORD

Cased _____ in., _____ ft.

Rig up _____

Sand _____

Drilling and Remarks:

Gas _____

Reported

Oil _____

Total Depth _____

PRODUCTION

1st 24 hrs. Nat. _____

1st 24 hrs. after shot _____

Gas _____ Cu. Ft.

Dry Hole _____

Abandoned _____

C S L NE SE

Date

DEC 6 1939

19

S. J. LEWIS

Scout

Map No. 71 Sec. 1 Twp. 11 R. 18WWell No. 2 Burnett "A"Wakefield

Company

Contractor

COMPLETED

SW NE SE

SECTION PLAT990 Ft. from N. Line Ft. from S. Line990 Ft. from E. Line Ft. from W. Line

PEAVEY POOL

Location _____

Rig up _____

Drilling and Remarks:

*Oil 83567**5" c 8569.**1000 Acid**Depthograph P. 8**10787**Maximum 2000***RECORD**

Cased _____ in., _____ ft.

Sand _____

Gas _____

Oil _____

Total Depth 2525**PRODUCTION**

1st 24 hrs. Nat. _____

1st 24 hrs. after shot _____

Gas _____ Cu. Ft.

Dry Hole _____

Abandoned _____

Date

DEC 2 1939S. J. LEWIS Scout