

Ellis


KANSAS

SECTION 1 TOWNSHIP 11 RANGE 18W

WELL NO. #5 Burnett "A"

COMPANY E.F. Wakefield

NORTH SE SE SE

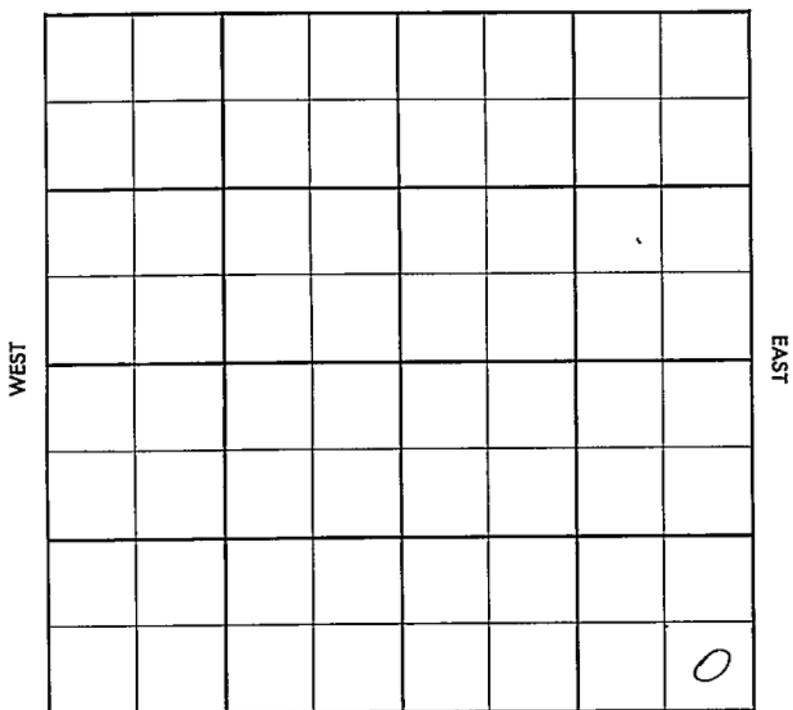

16

0

Co.

Loc.

No.

Sec.

T.

R.

County Elbert Elev. 1926 DF
 Sec. 1 Twp. 11 Rge. 18W
 Company F. F. Wakefield
 Farm Name Burnett "A" No. 5

TOPS	DEPTH	LOG	DATUM
Anh.			
TP.	<u>2870</u>		
H.		<u>3108</u>	
Tr.		<u>3129</u>	
Dg.	<u>3115</u>		
Bl.			
L.	<u>3132</u>	<u>3150</u>	
K.C.			
B.K.C.		<u>3383</u>	
Ce.			
C.	<u>3405</u>	<u>3406</u>	
M.			
M.			
K.			
Mz.			
Mo.			
V.			
S.	<u>3435</u>		
S.			
A.	<u>3457</u>	<u>3454</u>	
R.			
PE.			
G.			
TD.	<u>3550</u>	<u>3530</u>	

Loc. in Sec. SE SE SE

Geol. Lerke

Contr. Co. tools

Pool Burnett

COMPLETE
 APR 24 '57

Date Comm. MIR Feb 13 '57 FRI 2-18-57
8 7/8 305/200 @ 1605 FEB 27 '57
5 1/2 @ .35 ⁴⁹ / 1050 " 5 '57 CO 12/
35 ¹⁰ - ¹⁴ Lots with PB 3500
32/3480-88 550 + lots with MAR 13 '57
Sy to pt MAR 20 '57 PF 32/34 ⁵⁸
- ⁶⁷ 1/2 FU 500' oil in the @
2 Boph no/w PGP MAR 27 '57
APR 3 '57 APR 10 '57 APR 17 '57 APR 24 '57 P. 25
Bopd no/w.