


Section 1 Township 11 Range 18-W

Well No. #2 Burnett

Company Wakefield et al

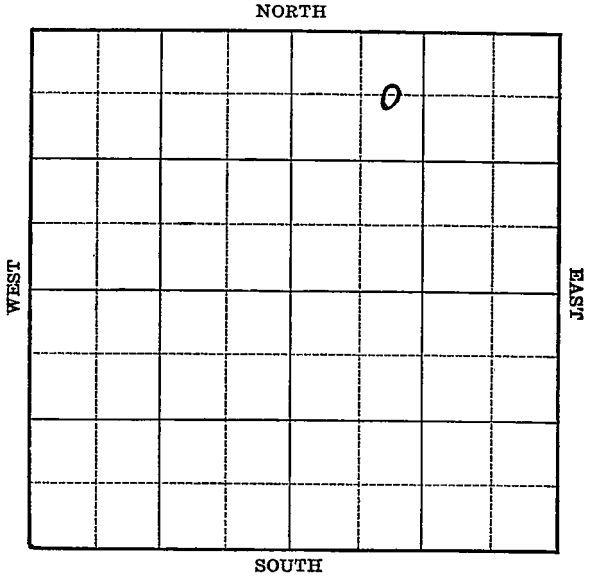

Sec. 1 Twp. 11 R. 18-W

Well No. #2 Burnett Farm

Wakefield et al Company


(Peavey)

660 Ft. from N. Line

_____ Ft. from S. Line

_____ Ft. from E. Line

990 Ft. from W. Line

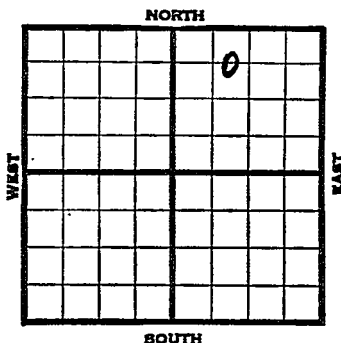

Elv. 1971

1939	REPORT
12/6	Rotary.
12/14	Anhy 1238' 8" - 1260' WOC.
12/21	Drilg. 2593'
12/28	" "
1940	
1/4	Arb. 3514' ^{3518'} 5" - 3514' ^{3518'}
	TD 3515' RUST.
1/11	T.D. 3516' 200' oil 1/4 hour.
1/18	T.D. 3520' 4000 acid. Testing.
1/24	Arb. 3518' (Corrected)
	5" - 3518' "
	4000 acid.
	T.D. 3520'
	Echometer Pot. 5806 bbls.
	Maximum 3000 bbls.
	COMPLETED

Map No. 71 Sec. 1 Twp. 11 R. 18W

Well No. 2 Burnett

Wakefield etal Company

Contractor

FIRST REPORT

C $E\frac{1}{2}$ NW NE

660 Ft. from N. Line

_____ Ft. from S. Line

_____ Ft. from E. Line

990 Ft. from W. Line

SECTION PLAT

			0

PEAVEY POOL

Location _____

Rig up _____

Drilling and Remarks:

Rotary

RECORD

Cased _____ in., _____ ft.

Sand _____

Gas _____

Oil _____

Total Depth _____

PRODUCTION

1st 24 hrs. Nat. _____

1st 24 hrs. after shot _____

Gas _____ Cu. Ft.

Dry Hole _____

Abandoned _____

Date

DEC 6 1939 19

S. I. LEWIS Scout

Map No. 71 Sec. 1 Twp. 11 R. 18WWell No. 2 BurnettWakefield etal

Company

Contractor

COMPLETED

SECTION PLAT

C $E\frac{1}{2}$ NW NE660 Ft. from N. Line

_____ Ft. from S. Line

_____ Ft. from E. Line

990 Ft. from W. Line

PEAVEY POOL

		0	

Location _____

Rig up _____

Drilling and Remarks:

*Oil & 3518 corrected**5" @ 3518.**4000 acid**Echometer Pt.**5806**Maximum 3000*

RECORD

Cased _____ in., _____ ft.

Sand _____

Gas _____

Oil _____

Total Depth 3520

PRODUCTION

1st 24 hrs. Nat. _____

1st 24 hrs. after shot _____

Gas _____ Cu. Ft.

Dry Hole _____

Abandoned _____

Date

JAN 24 1940S. J. LEWIS

Scout