

Ellis


KANSAS

Form 51-5M-7-39-Palace

Section 1 Township 11 Range 18-W

Well No. #1 Riddler

Company Tidewater

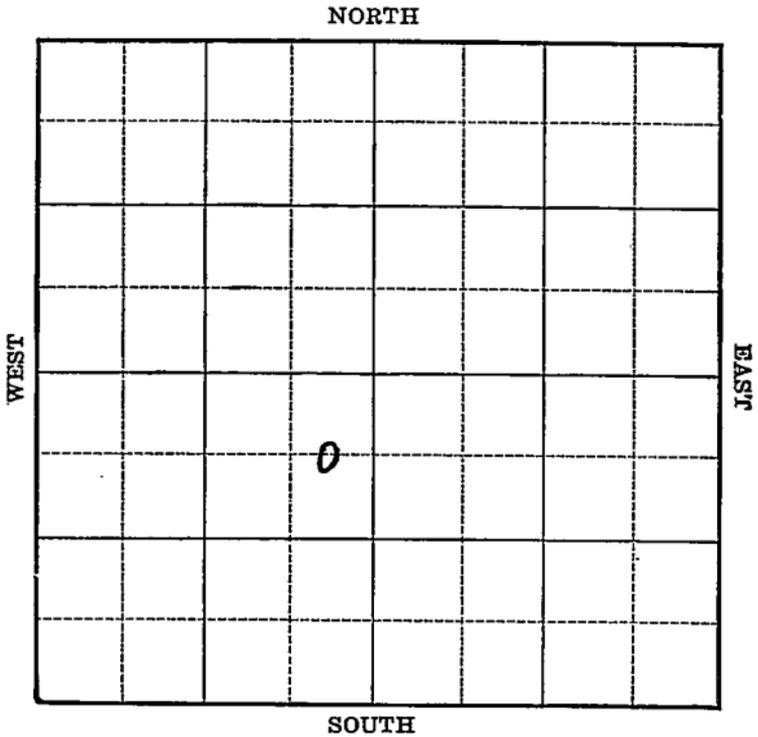

Sec. 1 Twp. 11 R. 18-W

Well No. #1 Riddler Farm

Tidewater

Company

(Burnett)


660 Ft. from N. Line

_____ Ft. from S. Line

330 Ft. from E. Line

_____ Ft. from W. Line

Elev. 1900

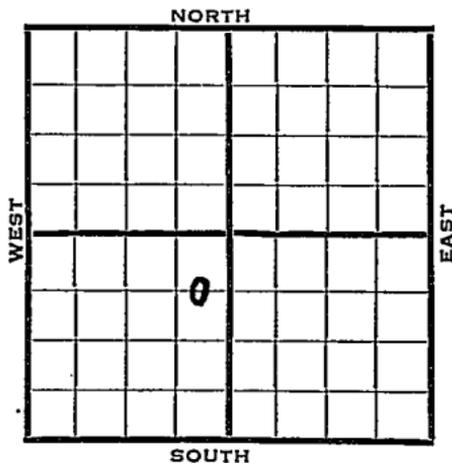

1940	REPORT
4/3	Location
4/12	Moving in rig.
4/18	Surface Hole.
4/25	13" - 130' Anhy 1175'
	8" - 1180' WOC.
5/2	Drig. 2710'
5/9	Lansing 3125' Cong. 3380'
	Arb. ³⁴⁴¹ 3541 -46' T.D. Run 5". (???????)
5/16	5" - 3444' T.D. 3447½'
	2600' oil 24 hours.
5/22	Arb. 3441'
	5" - 3444'
	T.D. 3447½'
	500 acid.
	Depthograph potential 13,185
	Maximum 3000 bbls.
	COMPLETED

Map No. 71 Sec. 1 Twp. 11 R. 18W

Well No. 1 Riddler

Tidewater Company

Contractor

FIRST REPORT

C E L NE SW


SECTION PLAT

660 Ft. from N. Line

_____ Ft. from S. Line

330 Ft. from E. Line

_____ Ft. from W. Line

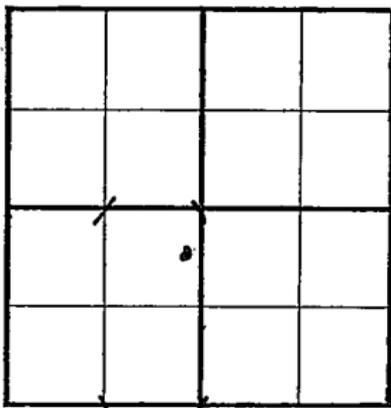

BURNETT POOL

Location X

Rig up _____

Drilling and Remarks:

RECORD

Cased _____ in., _____ ft.

Sand _____

Gas _____

Oil _____

Total Depth _____

PRODUCTION

1st 24 hrs. Nat. _____

1st 24 hrs. after shot _____

Gas _____ Cu. Ft.

Dry Hole _____

Abandoned _____

Date

APR 3 1940 19

S. J. LEWIS Scout

Map No. 71 Sec. 1 Twp. 11 R. 18WWell No. 1 RiddlerTidewater

Company

Contractor

COMPLETED

C E L N E SW


660 Ft. from N. Line

_____ Ft. from S. Line

330 Ft. from E. Line

_____ Ft. from W. Line

BURNETT POOL

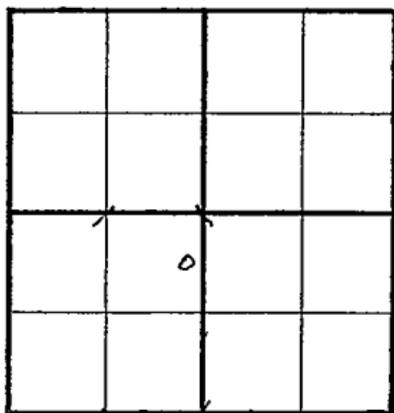SECTION PLAT

Location _____

Rig up _____

Drilling and Remarks:

*Q 83441**5103444**500 acid***Depthograph Post
13185**Maximum 3000***RECORD**

Cased _____ in., _____ ft.

Sand _____

Gas _____

Oil _____

Total Depth 3447 1/2**PRODUCTION**

1st 24 hrs. Nat. _____

1st 24 hrs. after shot _____

Gas _____ Cu. Ft.

Dry Hole _____

Abandoned _____

Date

MAY 22 1940₁₉S. J. LEWIS Scout