


Section 1 Township 11 Range 18-W

Well No. #4 Burnett "A"

Company Wakefield

NORTH Burnett Arb.Pool

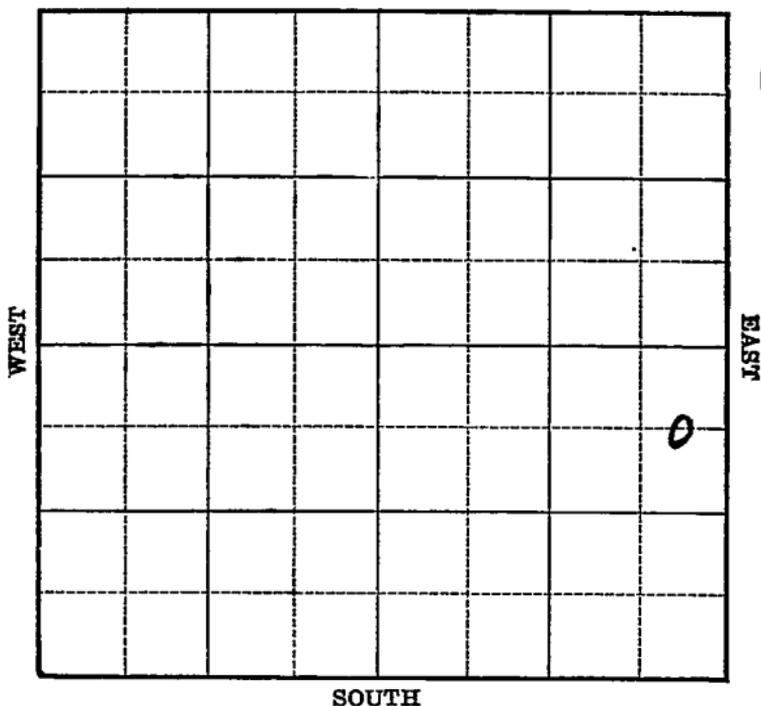

SOUTH

Sec. 1 Twp. 11 R. 18-W

Well No. #4 Burnett "A" Farm

Wakefield

Company


(Burnett Arb.)

660 Ft. from N. Line

_____ Ft. from S. Line

330 Ft. from E. Line

_____ Ft. from W. Line

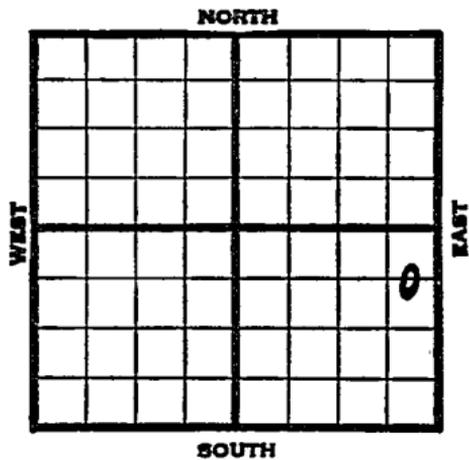

Elev. 1961

1940	REPORT
2/14	Derrick.
2/23	"
2/29	"
3/8	13" - 60' Anh. 1309'
	8" - 1314'
3/14	Drlg. 2400'
3/21	Drlg. 3055'
3/28	Arb. 3502' T.D. 3503'
	5" - 3502' RUST.
4/4	T.D. 3505' 2800' oil 12 hours.
4/12	1000 acid. 2000 acid.
	Testing.
4/17	Arb. 3502'
	5" - 3502'
	T.D. 3505'
	3000 acid.
	Echometer potential 5200 bbls.
	Maximum 3000 bbls.
	COMPLETED

Map No. 71 Sec. 1 Twp. 11 R. 18W

Well No. 4 Burnett "A"

Wakefield

Company

Contractor

FIRST REPORT

C E L N E S E

660 Ft. from N. Line

_____ Ft. from S. Line

330 Ft. from E. Line

_____ Ft. from W. Line

SECTION PLAT

			o

BURNETT ARB. POOL

Location _____

Rig up _____

Drilling and Remarks:
Derrick

RECORD

Cased _____ in., _____ ft.

Sand _____

Gas _____

Oil _____

Total Depth _____

PRODUCTION

1st 24 hrs. Nat. _____

1st 24 hrs. after shot _____

Gas _____ Cu. Ft.

Dry Hole _____

Abandoned _____

Date

FEB 14 1940 19

S. J. LEWIS Scout

Map No. 71 Sec. 1 Twp. 11 R. 18WWell No. 4 Burnett "A"Wakefield

Company

Contractor

COMPLETED**SECTION PLAT**

			o

660 **C E L N E S E**

Ft. from N. Line

Ft. from S. Line

330 Ft. from E. Line

Ft. from W. Line

BURNETT ARB. POOL

Location _____

Rig up _____

Drilling and Remarks:

*Out 3502.**5" C 3502.**3000 Acid**Echometer 28**5200**Maximum 3000***RECORD**

Cased _____ in., _____ ft.

Sand _____

Gas _____

Oil _____

Total Depth 3505.**PRODUCTION**

1st 24 hrs. Nat. _____

1st 24 hrs. after shot _____

Gas _____ Cu. Ft.

Dry Hole _____

Abandoned _____

Date

APR 17 1940 19S. J. LEWIS

Scout